


1 LOCATION OF WATER WELL:	Fraction	Section Number	Township Number	Range Number
County: <b>Cowley</b>	<b>SE 1/4 NW 1/4 SW 1/4</b>	<b>32</b>	<b>T 34 S</b>	<b>R 4</b> <b>E/W</b>

Distance and direction from nearest town or city street address of well if located within city?  
**1400 So. M St., Arkansas City**

2 WATER WELL OWNER: <b>MRP Properties Company, LLC</b>	Board of Agriculture, Division of Water Resources Application Number:
RR#, St. Address, Box #: <b>1400 South M Street</b>	
City, State, ZIP Code: <b>Arkansas City, KS 67005</b>	

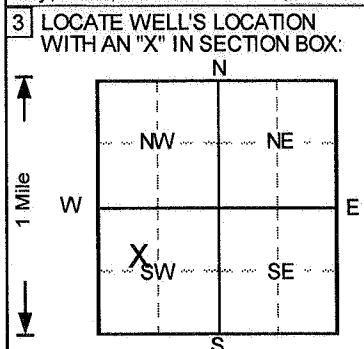

4 DEPTH OF COMPLETED WELL ..... **29.5** ..... ft. ELEVATION: ..... **1062.73** ..... ft.

Depth(s) Groundwater Encountered 1. .... ft. 2. .... ft. 3. .... ft.

WELL'S STATIC WATER LEVEL ..... ft. below land surface measured on mo/day/yr

Pump test data: Well water was **NA** ft. after ..... hours pumping ..... gpm

Est. Yield **NA** gpm: Well water was ..... ft. after ..... hours pumping ..... gpm

Bore Hole Diameter ..... **8** ..... in. to ..... **30.5** ..... ft., and ..... in. to ..... ft.

WELL WATER TO BE USED AS:

5 Public water supply	8 Air conditioning	11 Injection well
1 Domestic	3 Feedlot	6 Oil field water supply
2 Irrigation	4 Industrial	7 Lawn and garden only
		<b>10 Monitoring well</b>

Was a chemical/bacteriological sample submitted to Department? Yes.....No  ; If yes, mo/day/yr sample was submitted

Water Well Disinfected? Yes No

5 TYPE OF BLANK CASING USED:

1 Steel	3 RMP (SR)	5 Wrought iron	8 Concrete tile	CASING JOINTS: Glued ..... Clamped .....
<b>2 PVC</b>	4 ABS	6 Asbestos-Cement	9 Other (specify below)	Welded .....
		7 Fiberglass		Threaded. <input checked="" type="checkbox"/>

Blank casing diameter ..... **2** ..... in. to ..... **19.5** ..... ft. Dia ..... in. to ..... ft.

Casing height above land surface ..... **32.76** ..... in., weight ..... lbs./ft. Wall thickness or gauge No. .... **Sch. 40** .....

TYPE OF SCREEN OR PERFORATION MATERIAL:

1 Steel	3 Stainless steel	5 Fiberglass	<b>7 PVC</b>	10 Asbestos-cement
2 Brass	4 Galvanized steel	6 Concrete tile	8 RMP (SR)	11 Other (specify) .....
			9 ABS	12 None used (open hole)

SCREEN OR PERFORATION OPENINGS ARE:

1 Continuous slot	<b>3 Mill slot</b>	5 Gauzed wrapped	8 Saw cut	11 None (open hole)
2 Louvered shutter	4 Key punched	6 Wire wrapped	9 Drilled holes	
		7 Torch cut	10 Other (specify) .....	

SCREEN-PERFORATED INTERVALS: From ..... **19.5** ..... ft. to ..... **29.5** ..... ft., From ..... ft. to ..... ft.

GRAVEL PACK INTERVALS: From ..... **17.5** ..... ft. to ..... **30.5** ..... ft., From ..... ft. to ..... ft.

6 GROUT MATERIAL: 1 Neat cement 2 Cement grout **3 Bentonite** **4 Other Concrete** .....

Grout Intervals: From ..... **0** ..... ft. to ..... **3** ..... ft., From ..... **3** ..... ft. to ..... **17.5** ..... ft., From ..... ft. to ..... ft.

What is the nearest source of possible contamination:

1 Septic tank	4 Lateral lines	7 Pit privy	10 Livestock pens	14 Abandoned water well
2 Sewer lines	5 Cess pool	8 Sewage lagoon	11 Fuel storage	15 Oil well/Gas well
3 Watertight sewer lines	6 Seepage pit	9 Feedyard	12 Fertilizer storage	16 Other (specify below)
			13 Insecticide storage	

Direction from well? How many feet?

FROM	TO	LITHOLOGIC LOG	FROM	TO	PLUGGING INTERVALS
0	5	Silt topsoil, sandy, Brown to Dark Brown			
5	8	Silt w/Sand, Dark Brown			
8	10	Clay, Black			
10	13	Clay, silty, Gray-Black			
13	16	Clay, sandy, Gray Black			
16	25	Sand, m, Dark Gray			
25	30.5	Sand, m, w/Dark Brown Clay zones, Dark Gra			
					MW-33C, Abovegrade

7 CONTRACTOR'S OR LANDOWNER'S CERTIFICATION: This water well was **(1)** constructed, (2) reconstructed, or (3) plugged under my jurisdiction and was completed on (mo/day/year) ..... **10/11/2013** ..... and this record is true to the best of my knowledge and belief.

Kansas Water Well Contractor's License No. .... **527** ..... This Water Well Record was completed on (mo/day/yr) ..... **11/19/13** ..... under the business name of **GeoCore, Inc.** by (signature) *Dale Bell*