


1 LOCATION OF WATER WELL: County: Cowley Fraction NE 1/4 SW 1/4 SW 1/4 Section Number 32 Township Number T 34 S Range Number R 4 E/W

Distance and direction from nearest town or city street address of well if located within city? 1400 So. M St., Arkansas City

2 WATER WELL OWNER: MRP Properties Company, LLC RR#: St. Address, Box #: 1400 South M Street City, State, ZIP Code: Arkansas City, KS 67005 Board of Agriculture, Division of Water Resources Application Number:

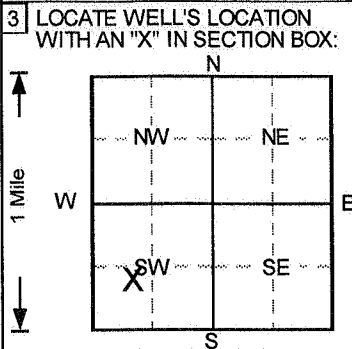

4 DEPTH OF COMPLETED WELL: 28 ft. ELEVATION: 1062.14. WELL'S STATIC WATER LEVEL: ft. below land surface measured on mo/day/yr. Pump test data: Well water was NA ft. after ... hours pumping ... gpm. Est. Yield: NA gpm. Bore Hole Diameter: 8 in. to 29 ft. and ... in. to ... ft. WELL WATER TO BE USED AS: 10 Monitoring well. Was a chemical/bacteriological sample submitted? Yes. Water Well Disinfected? Yes.

5 TYPE OF BLANK CASING USED: 2 PVC, 7 Fiberglass. CASING JOINTS: Threaded. Blank casing diameter: 2 in. to 18 ft. Dia. Casing height above land surface: 35.28 in., weight ... lbs./ft. Wall thickness or gauge No. Sch. 40. TYPE OF SCREEN OR PERFORATION MATERIAL: 7 PVC. SCREEN OR PERFORATION OPENINGS ARE: 3 Mill slot. SCREEN-PERFORATED INTERVALS: From 18 ft. to 28 ft. GRAVEL PACK INTERVALS: From 16 ft. to 29 ft.

6 GROUT MATERIAL: 3 Bentonite, 4 Other Concrete. Grout Intervals: From 0 ft. to 3 ft., From 3 ft. to 10 ft. What is the nearest source of possible contamination: 1 Septic tank, 4 Lateral lines, 7 Pit privy, 10 Livestock pens, 14 Abandoned water well, etc.

LITHOLOGIC LOG and PLUGGING INTERVALS table with columns FROM, TO, LITHOLOGIC LOG, FROM, TO, PLUGGING INTERVALS. Includes entries like 'Silt, sandy, Brown' and 'MW-28C, Abovegrade'.

7 CONTRACTOR'S OR LANDOWNER'S CERTIFICATION: This water well was (1) constructed, (2) reconstructed, or (3) plugged under my jurisdiction and was completed on: 10/11/2013. Kansas Water Well Contractor's License No. 527. This Water Well Record was completed on: 11/19/13 under the business name of GeoCore, Inc. by (signature) Dale Bell.