
WATER WELL PLUGGING R	ECORD Form WW		KSA 82	a-1212 ID NO.		
1 LOCATION OF WATER WELL: County: Cowley	Fraction SE ¼ SW¼ NE ¼ SW ½			Township Number T 34 S	Range Number 4 ✓ E □ W	
Street/Rural Address of Well Location; if unknown, distance &			Global Positioning Systems (GPS) information:			
direction from nearest town or intersecti		Latitude: 37.04587 (in decimal degrees)				
check here 🗸			Longitude: <u>-97.01545</u> (in decimal degrees)			
			Elevation: 1070			
			Horizontal Datum: WGS84, NAD83, NAD27 Collection Method:			
2 WATER WELL OWNER: MRP Properties Company, LLC				re/Model:		
RR#, St. Address, Box #: 1400 South M Street			☑ Digital Map/Photo, ☑ Topographic Map, ☐ Land Survey			
City, State ZIP Code: Arkansas City, KS 67005			Est. Accuracy: □ <3 m,			
3 MARK WELL'S LOCATION 4 DEPTH OF WELL 45.5 ft.						
						BOX: WELL'S STATIC WATER LEVEL 30.77 ft
WELL WAS USED AS:						
NW NE Domestic Public Water Supply Dewatering						
NW NE Domestic Public Water Supply Dewatering Irrigation Oil Field Water Supply Monitoring						
Industrial Air Conditioning Other Air Sparge						
SW X SE SE All Conditioning Be Other All Sparge						
Was a chemical/bacteriological sample submitted to Department? Yes No 🗸						
5 TYPE OF BLANK CASING USED:						
Steel RMP (SR) Wrought Fiberglass Other (Specify below)						
PVC ABS Asbestos-Cement Concrete Tile						
Blank casing diameter 2 in. Was casing pulled? Yes 🗹 No 🗌 If yes, how much 3.0 ft AGS to 1 ft BGS						
Casing height above or below land	surface 36.0 in.					
6 GROUT PLUG MATERIAL: Neat cement Cement grout Bentonite Other						
- Comon group Demonte — Other						
Grout Plug Intervals: From 1 ft. to 45.5 ft., From ft. to ft., From ft. to ft.						
What is the nearest source of possible contamination:						
Septic tank Seepage pit Fuel storage Other (specify below)						
Sewer lines Pit privy Fertilizer storage — Located at former refinery						
Watertight sewer lines Sewage lagoon Insecticide storage						
Lateral lines Feedyard Abandoned water well Direction from well?						
Cess pool Livestock pens Oil well/Gas well How many feet?						
EDOM TO DIVIS	CINICIMATERIALO	ED ON 1	TO.	DI LICCOLE	MATERIALS	
	GING MATERIALS	FROM	ТО	PLUGGING .	MATERIALS	
0 ft. 1 ft. Medium ber	· · · · · · · · · · · · · · · · · · ·					
1 ft. 45.5 ft. Neat cemen	t grout			The plugging metho		
				by KDHE, email fror	n Pam Chaffee to	
				Jay Mednick May 1	0, 2017.	
					·	
7 CONTRACTOR'S OR LANDOWNER'S CERTIFICATION: This water well was plugged under my jurisdiction and was						
completed on (mo/day/year) 06/09/2017 and this record is true to the best of my knowledge and belief. Kansas Water						
Well Contractor's License No. Owner . This Water Well Record was completed of (no/day/year) 06/27/2017 under the						
business name of MRP Properties Company, LLC by (signature) by (signature)						
Send one white copy to Kansas Department of Health & Environment, Geology Section, 1000 SW Jackson Street, Ste. 420, Topeka, KS						
					, Ste. 420, Topeka, KS	
	nd one copy to WATER WEI					
Visit us at http://www.kdheks.gov/waterwell/index.html Telephone 785-296-5524.						
	KCAC	32a-1212		1	Davised 1/20/2015	
	NSA	02a-1212		J	Revised 1/20/2015	

CSI C4-AS

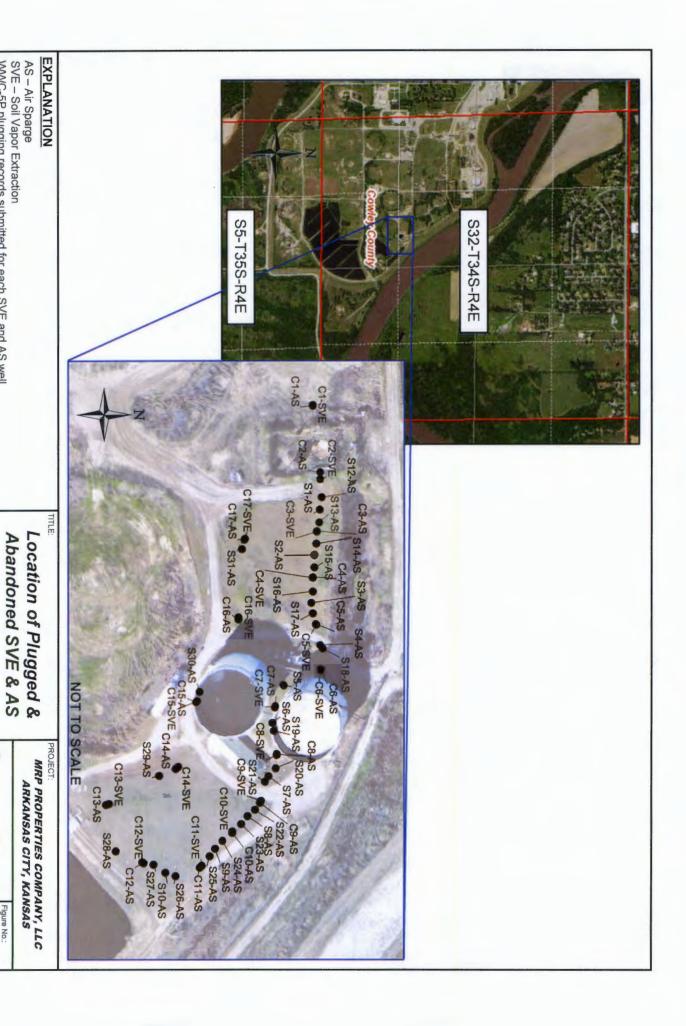

WWC-5P plugging records submitted for each SVE and AS well

Wells - CSI System

⊕ MWH. □ Stantec

Figure No.: