

## WATER WELL PLUGGING RECORD Form WWC-5P

KSA 82a-1212

ID NO.

CSI C14-SVE

<b>1 LOCATION OF WATER WELL:</b> County: <u>Cowley</u> Street/Rural Address of Well Location; if unknown, distance & direction from nearest town or intersection: If at owner's address, check here <input checked="" type="checkbox"/>	Fraction <u>NW 1/4 NE 1/4 SE 1/4 SW 1/4</u> Section Number <u>32</u> Township Number <u>T 34 S</u> Range Number <u>4</u> <input checked="" type="checkbox"/> E <input type="checkbox"/> W	<b>Global Positioning Systems (GPS) information:</b> Latitude: <u>37.04539</u> (in decimal degrees) Longitude: <u>-97.01464</u> (in decimal degrees) Elevation: <u>1070</u> Horizontal Datum: <input type="checkbox"/> WGS84, <input checked="" type="checkbox"/> NAD83, <input type="checkbox"/> NAD27 Collection Method: <input type="checkbox"/> GPS unit (Make/Model: _____) <input checked="" type="checkbox"/> Digital Map/Photo, <input checked="" type="checkbox"/> Topographic Map, <input type="checkbox"/> Land Survey Est. Accuracy: <input type="checkbox"/> < 3 m, <input checked="" type="checkbox"/> 3-5 m, <input type="checkbox"/> 5-15 m, <input type="checkbox"/> > 15 m
---	--	--

<b>2 WATER WELL OWNER:</b> MRP Properties Company, LLC RR#, St. Address, Box #: <u>1400 South M Street</u> City, State ZIP Code: <u>Arkansas City, KS 67005</u>	<b>3 MARK WELL'S LOCATION WITH AN "X" IN SECTION BOX:</b> <div style="text-align: center;"> </div>	<b>4 DEPTH OF WELL</b> <u>28.5</u> <b>ft.</b> WELL'S STATIC WATER LEVEL <u>28.24</u> <b>ft</b> WELL WAS USED AS: <div style="display: flex; justify-content: space-between;"> <div> <input type="checkbox"/> Domestic  <input type="checkbox"/> Irrigation  <input type="checkbox"/> Feedlot  <input type="checkbox"/> Industrial         </div> <div> <input type="checkbox"/> Public Water Supply  <input type="checkbox"/> Oil Field Water Supply  <input type="checkbox"/> Domestic (Lawn &amp; Garden)  <input type="checkbox"/> Air Conditioning         </div> <div> <input type="checkbox"/> Dewatering  <input type="checkbox"/> Monitoring  <input type="checkbox"/> Injection Well  <input checked="" type="checkbox"/> Other <u>Soil Vapor Ext</u> </div> </div> Was a chemical/bacteriological sample submitted to Department? Yes <input type="checkbox"/> No <input checked="" type="checkbox"/>
---	---	--

  
**5 TYPE OF BLANK CASING USED:**  
☐ Steel ☐ RMP (SR) ☐ Wrought ☐ Fiberglass ☐ Other (Specify below) \_\_\_\_\_  
☒ PVC ☐ ABS ☐ Asbestos-Cement ☐ Concrete Tile  
 Blank casing diameter 2 in. Was casing pulled? Yes ☒ No ☐ If yes, how much 3.0 ft AGS to 1 ft BGS  
 Casing height above or below land surface 36.0 in.
   
  
**6 GROUT PLUG MATERIAL:** ☒ Neat cement ☐ Cement grout ☐ Bentonite ☐ Other \_\_\_\_\_  
 Grout Plug Intervals: From 1 ft. to 28.5 ft., From \_\_\_\_\_ ft. to \_\_\_\_\_ ft., From \_\_\_\_\_ ft. to \_\_\_\_\_ ft.  
 What is the nearest source of possible contamination:  

☐ Septic tank  
☐ Sewer lines  
☐ Watertight sewer lines  
☐ Lateral lines  
☐ Cess pool

☐ Seepage pit  
☐ Pit privy  
☐ Sewage lagoon  
☐ Feedyard  
☐ Livestock pens

☐ Fuel storage  
☐ Fertilizer storage  
☐ Insecticide storage  
☐ Abandoned water well  
☐ Oil well/Gas well

☒ Other (specify below)  
Located at former refinery  
 Direction from well? \_\_\_\_\_  
 How many feet? \_\_\_\_\_

FROM	TO	PLUGGING MATERIALS	FROM	TO	PLUGGING MATERIALS
0 ft.	1 ft.	Medium bentonite chips			
1 ft.	28.5 ft.	Neat cement grout			
					The plugging method was approved by KDHE, email from Pam Chaffee to Jay Mednick May 10, 2017.


  
**7 CONTRACTOR'S OR LANDOWNER'S CERTIFICATION:** This water well was plugged under my jurisdiction and was completed on (mo/day/year) 06/09/2017 and this record is true to the best of my knowledge and belief. Kansas Water Well Contractor's License No. Owner. This Water Well Record was completed on (mo/day/year) 06/27/2017 under the business name of MRP Properties Company, LLC by (signature) [Signature]

Send one white copy to Kansas Department of Health & Environment, Geology Section, 1000 SW Jackson Street, Ste. 420, Topeka, KS 66612-1367. Send one copy to WATER WELL OWNER and retain one for your records.

Visit us at <http://www.kdheks.gov/waterwell/index.html> Telephone 785-296-5524.

KSA82a-1212

Revised 1/20/2015

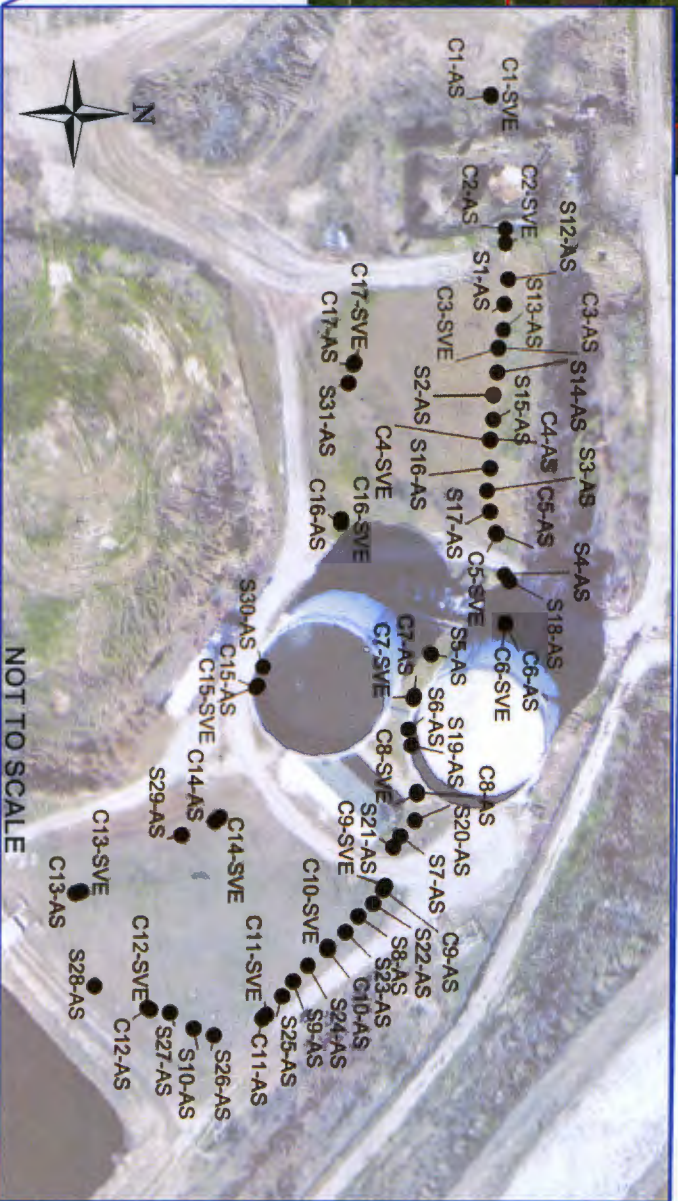

**EXPLANATION**

AS – Air Sparge  
SVE – Soil Vapor Extraction  
WWC-5P plugging records submitted for each SVE and AS well

TITLE:

**Location of Plugged &  
Abandoned SVE & AS  
Wells – CSI System**

PROJECT:


**MRP PROPERTIES COMPANY, LLC  
ARKANSAS CITY, KANSAS**



Figure No.:

**1**



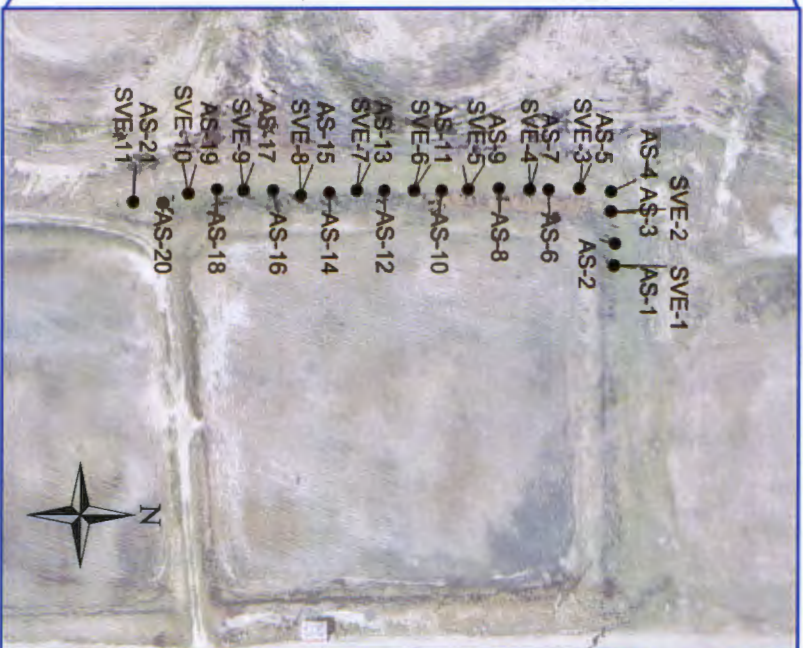

NOT TO SCALE

# EXPLANATION

AS – Air Sparge  
SVE – Soil Vapor Extraction  
WWC-5P plugging records submitted for each SVE and AS well

TITLE:

**Location of Plugged &  
Abandoned SVE & AS  
Wells – LTU System**

PROJECT:

**MRP PROPERTIES COMPANY, LLC  
ARKANSAS CITY, KANSAS**



**MWH**



**Stantec**

Figure No.:

**2**