

WATER WELL PLUGGING RECORD Form WWC-5P

KSA 82a-1212

ID NO.

CSI S25-AS

1 LOCATION OF WATER WELL: County: <u>Cowley</u> Street/Rural Address of Well Location; if unknown, distance & direction from nearest town or intersection: If at owner's address, check here ☒	Fraction <u>NW ¼ NE ¼ SE ¼ SW ¼</u> Section Number <u>32</u> Township Number <u>T 34 S</u> Range Number <u>4</u> ☒ E ☐ W	Global Positioning Systems (GPS) information: Latitude: <u>37.04549</u> (in decimal degrees) Longitude: <u>-97.01425</u> (in decimal degrees) Elevation: <u>1070</u> Horizontal Datum: ☐ WGS84, ☒ NAD83, ☐ NAD27 Collection Method: ☐ GPS unit (Make/Model: _____) ☒ Digital Map/Photo, ☒ Topographic Map, ☐ Land Survey Est. Accuracy: ☐ < 3 m, ☒ 3-5 m, ☐ 5-15 m, ☐ > 15 m
---	--	--

2 WATER WELL OWNER: MRP Properties Company, LLC RR#, St. Address, Box #: <u>1400 South M Street</u> City, State ZIP Code: <u>Arkansas City, KS 67005</u>	3 MARK WELL'S LOCATION WITH AN "X" IN SECTION BOX: 	4 DEPTH OF WELL <u>45.0</u> ft. WELL'S STATIC WATER LEVEL <u>31.22</u> ft WELL WAS USED AS: ☐ Domestic ☐ Irrigation ☐ Feedlot ☐ Industrial ☐ Public Water Supply ☐ Oil Field Water Supply ☐ Domestic (Lawn & Garden) ☐ Air Conditioning ☐ Dewatering ☐ Monitoring ☐ Injection Well ☒ Other <u>Air Sparge</u> Was a chemical/bacteriological sample submitted to Department? Yes ☐ No ☒
---	---	--

5 TYPE OF BLANK CASING USED:

☐ Steel
☒ PVC

☐ RMP (SR)
☐ ABS

☐ Wrought
☐ Asbestos-Cement

☐ Fiberglass
☐ Concrete Tile

☐ Other (Specify below) _____

 Blank casing diameter 2 in. Was casing pulled? Yes ☒ No ☐ If yes, how much 2.79 ft AGS to 1 ft BGS
 Casing height above or below land surface 33.48 in.

6 GROUT PLUG MATERIAL: ☒ Neat cement ☐ Cement grout ☐ Bentonite ☐ Other _____
 Grout Plug Intervals: From 1 ft. to 45.0 ft., From _____ ft. to _____ ft., From _____ ft. to _____ ft.
 What is the nearest source of possible contamination:

☐ Septic tank
☐ Sewer lines
☐ Watertight sewer lines
☐ Lateral lines
☐ Cess pool

☐ Seepage pit
☐ Pit privy
☐ Sewage lagoon
☐ Feedyard
☐ Livestock pens


☐ Fuel storage
☐ Fertilizer storage
☐ Insecticide storage
☐ Abandoned water well
☐ Oil well/Gas well

☒ Other (specify below)
Located at former refinery
 Direction from well? _____
 How many feet? _____

FROM	TO	PLUGGING MATERIALS
0 ft.	1 ft.	Medium bentonite chips
1 ft.	45.0 ft.	Neat cement grout

7 CONTRACTOR'S OR LANDOWNER'S CERTIFICATION: This water well was plugged under my jurisdiction and was completed on (mo/day/year) 06/09/2017 and this record is true to the best of my knowledge and belief. Kansas Water Well Contractor's License No. Owner. This Water Well Record was completed on (mo/day/year) 06/27/2017 under the business name of MRP Properties Company, LLC by (signature) [Signature]

Send one white copy to Kansas Department of Health & Environment, Geology Section, 1000 SW Jackson Street, Ste. 420, Topeka, KS 66612-1367. Send one copy to WATER WELL OWNER and retain one for your records.
 Visit us at <http://www.kdheks.gov/waterwell/index.html> Telephone 785-296-5524.

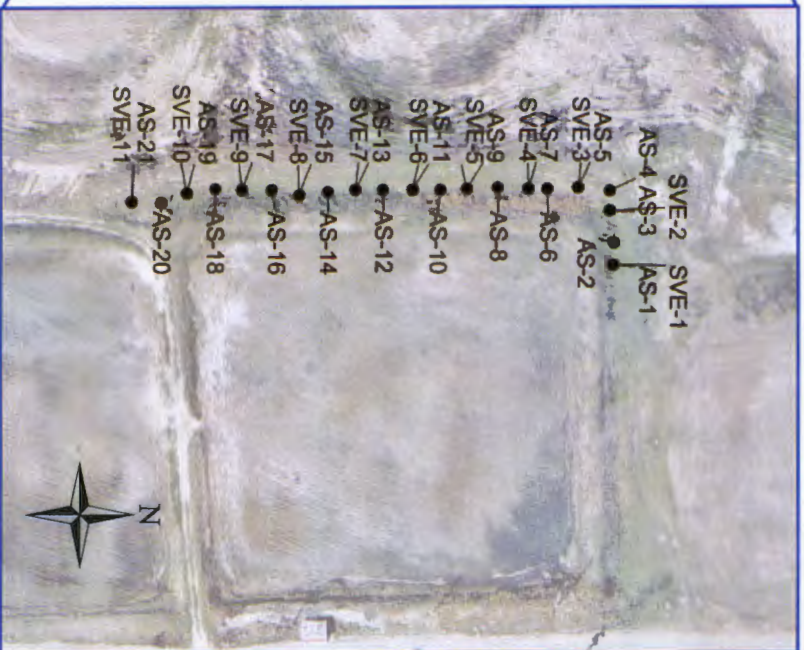

NOT TO SCALE

EXPLANATION

AS – Air Sparge
SVE – Soil Vapor Extraction
WWC-5P plugging records submitted for each SVE and AS well

TITLE:

**Location of Plugged &
Abandoned SVE & AS
Wells – LTU System**

PROJECT:

**MRP PROPERTIES COMPANY, LLC
ARKANSAS CITY, KANSAS**



MW



Stantec

Figure No.:

2