


Cowley

NE NE NE NE
SE SE SE SE
SW SW SW SW
NW NW NW NW

13-34-3E
2-34-3E
7-34-4E
18-34-4E

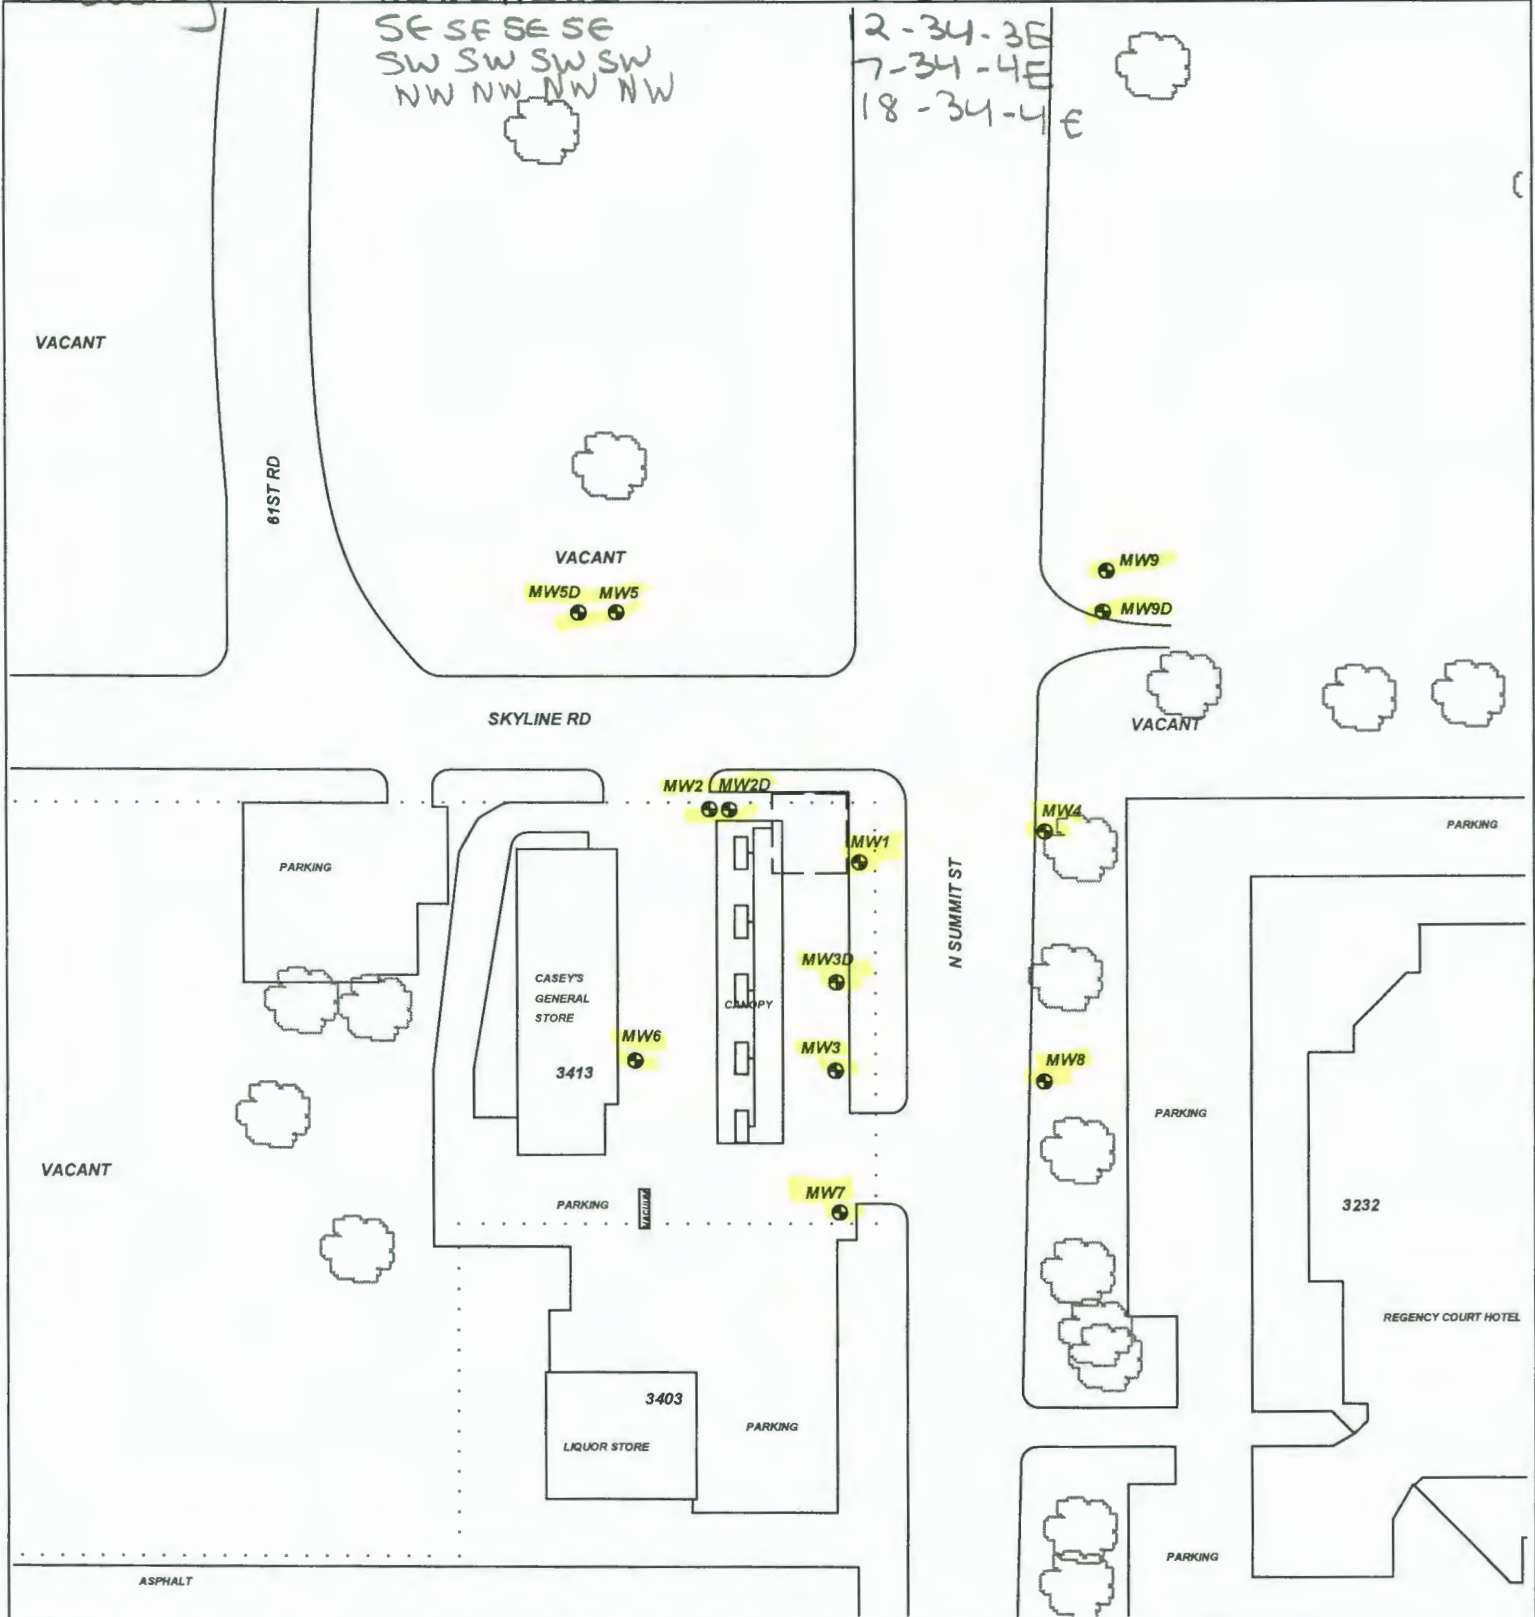

PROJECT: CASEY'S GENERAL STORE #3435		TITLE:		LEGEND: = CURRENT UST's (1)8,000 & (1)12,000 GAL GASOLINE, (1)10,000 GAL. DIESEL = MONITOR WELL = CURRENT PUMPS AND PRODUCT LINES = SUBJECT PROPERTY
ADDRESS: 3413 N. SUMMIT		ASSOCIATED ENVIRONMENTAL INC.		
LOCATION: ARKANSAS CITY, KS				
DRAWN BY: B. STALNAKER	DATE: 4/26/17	NOTES: No basements observed within 500'.		
REVISED BY: B. STALNAKER	DATE: 9/27/18			
AEI JOB #: TF501	KDHE JOB #: U2-018-14122			
SCALE: 1" = 100' 				