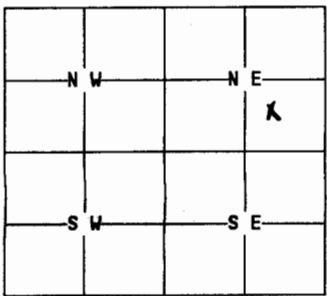


1	LOCATION OF WATER WELL: County: Cowley	Fraction SW 1/4, NE 1/4 NW 1/4 SE 1/4 NE 1/4	Section Number 22	Township Number 34	Range Number 5 E
---	--	---	-----------------------------	------------------------------	----------------------------

Distance and direction from nearest town or city street address of well if located within city?

2 WATER WELL OWNER: **Roger Black**
 RR#, St. Address, Box #: **16672 HWY 166**
 City, State, ZIP Code: **Ark City, KS 67005**
 Board of Agriculture, Division of Water Resources
 Application Number:

3	MARK WELL'S LOCATION WITH AN "X" IN SECTION BOX: N  S	4	DEPTH OF WELL.....ft. 18.5' WELL'S STATIC WATER LEVEL.....ft. 14.5' WELL WAS USED AS: <input checked="" type="checkbox"/> 1 Domestic <input type="checkbox"/> 2 Irrigation <input type="checkbox"/> 3 Feedlot <input type="checkbox"/> 4 Industrial <input type="checkbox"/> 5 Public Water Supply <input type="checkbox"/> 6 Oil Field Water Supply <input type="checkbox"/> 7 Lawn and Garden Only <input type="checkbox"/> 8 Air Conditioning <input type="checkbox"/> 9 Dewatering <input type="checkbox"/> 10 Monitoring Well <input type="checkbox"/> 11 Injection Well <input type="checkbox"/> 12 Other..... Was a chemical/bacteriological sample submitted to Department? Yes....No <input checked="" type="checkbox"/> If yes, mo/day/yr sample was submitted..... Water Well Disinfected: Yes... <input checked="" type="checkbox"/> No.....
---	---	---	---

5 TYPE OF BLANK CASING USED:
 1 Steel
 2 PVC
 3 RMP (SR)
 4 ABS
 5 Wrought
 6 Asbestos-Cement
 7 Fiberglass
 8 Concrete Tile
 9 Other (specify below).....
 Blank casing diameter.....in. Was casing pulled? Yes..... No..... If yes, how much.....
 Casing height above or below land surface.....in.

6 GROUT PLUG MATERIAL: 1 Neat cement 2 Cement grout 3 Bentonite 4 Other.....
 Grout Plug Intervals: From.....ft. to.....ft., From.....ft. to.....ft., From..... to.....ft.
 What is the nearest source of possible contamination:
 1 Septic tank
 2 Sewer lines
 3 Watertight sewer lines
 4 Lateral lines
 5 Cess Pool
 6 Seepage pit
 7 Pit privy
 8 Sewage lagoon
 9 Feedyard
 10 Livestock pens
 11 Fuel storage
 12 Fertilizer storage
 13 Insecticide storage
 14 Abandoned water well
 15 Oil well/Gas well
 16 Other (specify below).....
Floodwater
 Direction from well? **East, West, North** How many feet? ... **150 yds**.....

FROM	TO	PLUGGING MATERIALS
18.5'	14.5'	1/2" to 4" gravel + sand / bleach sp
14.5'	6'	Soil - sub
6'	3'	Bentonite plug w/ Mushroom
3'	0'	Topsoil

7 CONTRACTOR'S OR LANDOWNER'S CERTIFICATION: This water well was plugged under my jurisdiction and was completed on (mo/day/year) **2/14/07** and this record is true to the best of my knowledge and belief. Kansas Water Well Contractor's License No. This Water Well Record was completed on (mo/day/year) under the business name of
 by (signature) **Roger Black** - owner

INSTRUCTIONS: Use typewriter or ball point pen. Please press firmly and print clearly. Please fill in blanks, underline or circle the correct answers. Send top three copies to Kansas Department of Health and Environment, Bureau of Water, Topeka, Kansas 66620-0001. Telephone: 913/296-3565. Send one to Water Well Owner and retain one for your records.

1 By Jenni Carr - water quality Coordinator