


1	LOCATION OF WATER WELL: County: Chautauqua	Fraction SE 1/4 NE 1/4 NE 1/4	Section Number 11	Township Number 34 S.	Range Number 8 E.
---	--	---	-----------------------------	---------------------------------	-----------------------------

Distance and direction from nearest town or city street address of well if located within city? **N/A**

2 WATER WELL OWNER: **City of Cedar Vale** (Well No. **4**)

RR#, St. Address, Box #: **P.O. Box 119** Board of Agriculture, Division of Water Resources
 City, State, ZIP Code : **Cedar Vale, KS 67024** Application Number: **Vested CQ001**

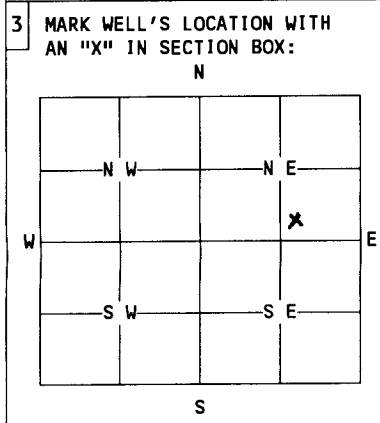

4 DEPTH OF WELL.....**32**.....ft.

WELL'S STATIC WATER LEVEL.....**15**.....ft.

WELL WAS USED AS: **Public Water Supply**

1 Domestic	<input checked="" type="checkbox"/> 5 Public Water Supply	9 Dewatering
2 Irrigation	<input checked="" type="checkbox"/> 6 Oil Field Water Supply	10 Monitoring Well
3 Feedlot	<input type="checkbox"/> 7 Lawn and Garden Only	11 Injection Well
4 Industrial	<input type="checkbox"/> 8 Air Conditioning	12 Other.....

Was a chemical/bacteriological sample submitted to Department? Yes....~~No~~**X**...
 If yes, mo/day/yr sample was submitted.....

Water Well Disinfected: Yes.....**X**..... No.....

5 TYPE OF BLANK CASING USED: **Steel**

<input checked="" type="checkbox"/> 1 Steel	<input type="checkbox"/> 3 RMP (SR)	<input type="checkbox"/> 5 Wrought	<input type="checkbox"/> 7 Fiberglass	<input type="checkbox"/> 9 Other (specify below)
<input type="checkbox"/> 2 PVC	<input type="checkbox"/> 4 ABS	<input type="checkbox"/> 6 Asbestos-Cement	<input type="checkbox"/> 8 Concrete Tile	

Blank casing diameter...**10**.....in. Was casing pulled? Yes..... No..~~X~~... If yes, how much.....
 Casing height ~~xxxxxx~~ below land surface.....**3.9** ft.....in.

6 GROUT PLUG MATERIAL: ~~XXXXXX~~ **1 Water cement** **2 Cement grout** ~~XXXXXX~~ **3 Bentonite** ~~XXXXXX~~ **4 Other**.....

GROUT PLUG INTERVALS: From **4**.....ft. to **15.5**.....ft., From.....ft. to.....ft., From..... to.....ft.

What is the nearest source of possible contamination:

1 Septic tank	6 Seepage pit	11 Fuel storage	16 Other (specify below)
2 Sewer lines	7 Pit privy	12 Fertilizer storage	Caney River
3 Watertight sewer lines	8 Sewage lagoon	13 Insecticide storage	
4 Lateral lines	9 Feedyard	14 Abandoned water well	
5 Cess Pool	10 Livestock pens	15 Oil well/Gas well	

Direction from well? **South**..... How many feet? **60**.....

FROM	TO	PLUGGING MATERIALS
0	4'	Clay
3'	15'	Cement Grout
15'	32'	River Gravel

7 CONTRACTOR'S OR LANDOWNER'S CERTIFICATION: This water well was plugged under my jurisdiction and was completed on (mo/day/year) **3-5-96**..... and this record is true to the best of my knowledge and belief. Kansas Water Well Contractor's License No. This Water Well Record was completed on (mo/day/year) **9-23-96**..... under the business name of **City of Cedar Vale, Kansas** by (signature) **Mayor Lloyd O. Lanning**.....

INSTRUCTIONS: Use typewriter or ball point pen. Please press firmly and print clearly. Please fill in blanks, underline or circle the correct answers. Send top three copies to Kansas Department of Health and Environment, Bureau of Water, Topeka, Kansas 66620-0001. Telephone: 913/296-3565. Send one to Water Well Owner and retain one for your records.