

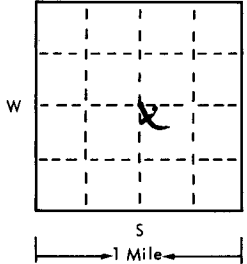
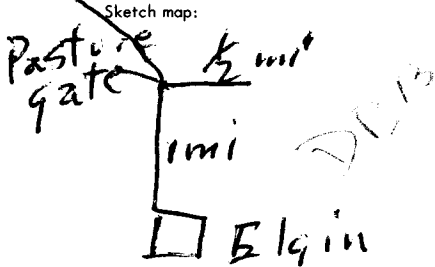
USE TYPEWRITER OR BALL
POINT PEN-PRESS FIRMLY,
PRINT CLEARLY.

WATER WELL RECORD
KSA 82a-1201-1215

T R EW sec 1/4 1/4 1/4 No.

Kansas State Dept. Of Health
(Water Well Contractors)
Forbes-Bldg. 740
Topeka, Kansas 66620

Chautauqua

1 Location of well:	County <i>C &</i>	Township name <i>Hendricks</i>	Fraction <i>NW NWSE</i>	Section number <i>11</i>	Town number <i>T35 S</i>	Range number <i>R 10 E</i>	
Distance and direction from nearest town or city:			3 Owner of well: <i>DR. Gary Keeney</i>				
Street address of well location if in city:			Address: <i>RT 1 Box 90 Sedon, KS 76316</i>				
Locate with "X" in section below: 			Sketch map: 			4 Well depth <i>235</i> ft. Date of completion <i>6-3-75</i> Well diameter <i>8</i> in.	
2 Type and color of material			From To		5 ☒ Cable tool ☐ Rotary ☐ Driven ☐ Dug ☐ Hollow rod ☐ Jetted ☐ Bored ☐ Reverse rotary		
					6 Use: ☒ Domestic ☐ Public supply ☐ Industry ☐ Irrigation ☐ Air conditioning ☐ Commercial ☐ Test well		
Sandy Soil Yellow Sandstone Blue Shale with 2" Lime Bed Alluvial Lime White Lime Shale (Blue) Blue Lime Green Shale Red Bed + Sandy Lime Green Sandstone, Blue Shale + Brown Shale Sandy Lime Blue Shale White Sandstone (show water) White Shale Water Sand (use a second test if needed)			7 Casing: Material <i>None</i> Height: above/below Threaded ☐ Welded ☐ Surface ☐ in. 
14 Nearest source of possible contamination: ft. <i>1600</i> Direction <i>N</i> Type <i>oil well</i> Well disinfected upon completion? ☐ Yes ☒ No			15 Pump: ☒ Not installed Manufacturer's name <i>None</i> Model number <i>None</i> HP <i>None</i> Volts <i>None</i> Length of drop pipe <i>None</i> ft. capacity <i>None</i> g.m.p. Type: ☐ Submersible ☐ Turbine ☐ Jet ☐ Reciprocating ☐ Centrifugal ☐ Other		17 Water well contractor's certification: This well was drilled under my jurisdiction and this report is true to the best of my knowledge and belief. <i>A+S Water Wells 301</i> Business name <i>Virgil KS</i> License No. <i>None</i> Address <i>Virgil KS</i> Signed <i>David Sherman</i> Date <i>6-3-75</i> Authorized representative		
			16 Remarks: elevation <i>Salty. Plugged at 190 + 7 2 sacks Cement</i>				

Topography:
☒ Hill
☐ Slope
☐ Upland
☐ Valley

Forward the white, blue and pink copies to the Kansas State Dept. Of Health.

*Filled + Plugged AT
Surface with 4 Sacks Cement*

6-3-75

Form WWC-5