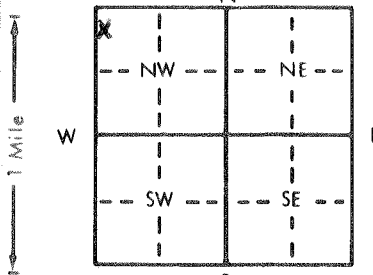


1 LOCATION OF WATER WELL:		Fraction	Section Number	Township Number	Range Number
County: <u>Chautauque</u>		<u>NW 1/4 NW 1/4 NW 1/4</u>	<u>17</u>	T <u>35</u> S	R <u>12</u> E/W
Distance and direction from nearest town or city street address of well if located within city? <u>3 Miles East of Chautauque</u>					
2 WATER WELL OWNER: <u>Wendell Faust</u>					
RR#, St. Address, Box #: <u>RR1 Box 35</u>					
City, State, ZIP Code: <u>Peru KS. 67360</u>					
Board of Agriculture, Division of Water Resource Application Number:					
3 LOCATE WELL'S LOCATION WITH AN "X" IN SECTION BOX:		4 DEPTH OF COMPLETED WELL: <u>89</u> ft. ELEVATION:			
		Depth(s) Groundwater Encountered 1. <u>20-31</u> ft. 2. <u>59-64</u> ft. 3. <u>10-12-85</u> ft.			
		WELL'S STATIC WATER LEVEL <u>18</u> ft. below land surface measured on mo/day/yr			
WELL WATER TO BE USED AS:					
1 Domestic 3 Feedlot 6 Oil field water supply 9 Dewatering 12 Other (Specify below)					
2 Irrigation 4 Industrial 7 Lawn and garden only 10 Observation well					
Was a chemical/bacteriological sample submitted to Department? Yes <u>No</u> <u>✓</u> If yes, mo/day/yr sample was submitted					
Water Well Disinfected? Yes <u>✓</u> No					
5 TYPE OF BLANK CASING USED:					
1 Steel 3 RMP (SR) 5 Wrought iron 8 Concrete tile CASING JOINTS: <u>Glued</u> <u>Clamped</u>					
2 <u>PVC</u> 4 ABS 6 Asbestos-Cement 9 Other (specify below) Welded					
3 Fiberglass Threaded					
TYPE OF SCREEN OR PERFORATION MATERIAL:					
1 Steel 3 Stainless steel 5 Fiberglass 8 RMP (SR) 10 Asbestos-cement					
2 Brass 4 Galvanized steel 6 Concrete tile 9 ABS 11 Other (specify)					
12 <u>None used (open hole)</u>					
SCREEN OR PERFORATION OPENINGS ARE:					
1 Continuous slot 3 Mill slot 5 Gauzed wrapped 8 <u>Saw cut</u> 11 None (open hole)					
2 Louvered shutter 4 Key punched 6 Wire wrapped 9 Drilled holes					
7 Torch cut 10 Other (specify)					
6 GROUT MATERIAL: 1 Neat cement 2 <u>Cement grout</u> 3 Bentonite 4 Other					
Grout Intervals: From <u>35</u> ft. to <u>59</u> ft. From <u>0</u> ft. to <u>17</u> ft. From <u>0</u> ft. to <u>17</u> ft.					
What is the nearest source of possible contamination:					
1 Septic tank 4 Lateral lines 7 Pit privy 10 Livestock pens 14 Abandoned water well					
2 Sewer lines 5 Cess pool 8 Sewage lagoon 11 Fuel storage 15 Oil well/Gas well					
3 Watertight sewer lines 6 Seepage pit 9 Feedyard 12 Fertilizer storage 16 Other (specify below)					
13 Insecticide storage					
Direction from well?					
How many feet?					
FROM TO LITHOLOGIC LOG FROM TO LITHOLOGIC LOG					
<u>0</u> <u>4</u> <u>Soil</u>					
<u>4</u> <u>18</u> <u>clay yellow</u>					
<u>18</u> <u>21</u> <u>orange clay</u>					
<u>21</u> <u>38</u> <u>shale blue</u>					
<u>38</u> <u>48</u> <u>shale dark</u>					
<u>48</u> <u>59</u> <u>shale gray</u>					
<u>59</u> <u>64</u> <u>sand gray fine</u>					
<u>64</u> <u>89</u> <u>shale gray</u>					
<u>71</u> <u>89</u> <u>5 G.P.H. 10</u>					
7 CONTRACTOR'S OR LANDOWNER'S CERTIFICATION: This water well was (1) <u>constructed</u> , (2) reconstructed, or (3) plugged under my jurisdiction and was completed on (mo/day/year) <u>oct 15, 1985</u> and this record is true to the best of my knowledge and belief. Kansas Water Well Contractor's License No. <u>442</u> This Water Well Record was completed on (mo/day/yr) <u>oct 15, 1985</u> under the business name of <u>C.B. Russell</u> by (signature) <u>C.B. Russell</u>					
INSTRUCTIONS: Use typewriter or ball point pen, PLEASE PRESS FIRMLY and PRINT clearly. Please fill in blanks, underline or circle the correct answers. Send to three copies to Kansas Department of Health and Environment, Division of Environment, Environmental Geology Section, Topeka, KS 66620. Send one to WATER WELL OWNER and retain one for your records.					