

1] LOCATION OF WATER WELL: County: Montgomery Fraction: NE 1/4 NE 1/4 SE 1/4 Section Number: 12 Township Number: T 35 S Range Number: R 13 E


Distance and direction from nearest town or city street address of well if located within city?

401 N MCGEE

MW-4

2] WATER WELL OWNER: Kerr McGEE Ref Corp
 RR#, St. Address, Box #: P.O. Box 3367
 City, State, ZIP Code: Houston, TX 77253
 Board of Agriculture, Division of Water Resources
 Application Number:

3] LOCATE WELL'S LOCATION WITH AN "X" IN SECTION BOX: 4] DEPTH OF COMPLETED WELL: 20.5 ft. ELEVATION:

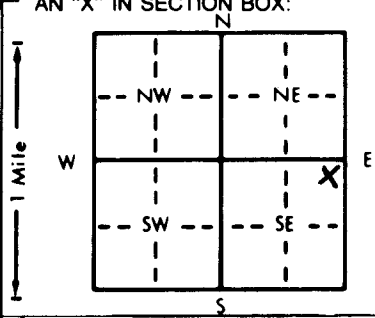

Depth(s) Groundwater Encountered 1. 10 ft. 2. 20.5 ft. 3. 20.5 ft.
 WELL'S STATIC WATER LEVEL 10 ft. below land surface measured on mo/day/yr
 WELL WATER TO BE USED AS: 5 Public water supply 8 Air conditioning 11 Injection well
 1 Domestic 3 Feedlot 6 Oil field water supply 9 Dewatering 12 Other (Specify below)
 2 Irrigation 4 Industrial 7 Lawn and garden only 10 Monitoring well
 Was a chemical/bacteriological sample submitted to Department? Yes X No X; If yes, mo/day/yr sample was submitted
 Water Well Disinfected? Yes X No X

5] TYPE OF BLANK CASING USED:
 1 Steel 3 RMP (SR) 5 Wrought iron 8 Concrete tile CASING JOINTS: Glued X Clamped X
2 PVC 4 ABS 6 Asbestos-Cement 9 Other (specify below) Welded X
 TYPE OF SCREEN OR PERFORATION MATERIAL: 0 PVC 10 Asbestos-cement
 1 Steel 3 Stainless steel 5 Fiberglass 8 RMP (SR) 11 Other (specify) X
 2 Brass 4 Galvanized steel 6 Concrete tile 9 ABS 12 None used (open hole)
 SCREEN OR PERFORATION OPENINGS ARE:
 1 Continuous slot 3 Mill slot 5 Gauzed wrapped 8 Saw cut 11 None (open hole)
 2 Louvered shutter 4 Key punched 6 Wire wrapped 9 Drilled holes
 7 Torch cut 10 Other (specify) 20.5
 SCREEN-PERFORATED INTERVALS: From 10.5 ft. to 20.5 ft. From 20.5 ft. to 20.5 ft.
 GRAVEL PACK INTERVALS: From 8 ft. to 20.5 ft. From 20.5 ft. to 20.5 ft.

6] GROUT MATERIAL: 0 Neat cement 8 2 Cement grout 3 Bentonite 4 Other
 Grout Intervals: From 0 ft. to 8 ft. From 8 ft. to 20.5 ft. From 20.5 ft. to 20.5 ft.
 What is the nearest source of possible contamination:
 1 Septic tank 4 Lateral lines 7 Pit privy 10 Livestock pens 14 Abandoned water well
 2 Sewer lines 5 Cess pool 8 Sewage lagoon 11 Fuel storage 15 Oil well/Gas well
 3 Watertight sewer lines 6 Seepage pit 9 Feedyard 12 Fertilizer storage 16 Other (specify below)
 13 Insecticide storage
 Direction from well? within gas station How many feet?

FROM	TO	LITHOLOGIC LOG	FROM	TO	PLUGGING INTERVALS
<u>0</u>	<u>10</u>	<u>Clayey silt</u>			<u>SES Engineers obtained flush mt. Variance.</u>
<u>10</u>	<u>15</u>	<u>Shale</u>			
<u>15</u>	<u>15.5</u>	<u>LS</u>			
<u>15.5</u>	<u>18</u>	<u>Alt. beds of Sh & LS</u>			
<u>18</u>	<u>19</u>	<u>LS</u>			
<u>19</u>	<u>20.5</u>	<u>Interbedded Shale & LS</u>			

7] CONTRACTOR'S OR LANDOWNER'S CERTIFICATION: This water well was (1) constructed, (2) reconstructed, or (3) plugged under my jurisdiction and was completed on (mo/day/year) 7/3/95 and this record is true to the best of my knowledge and belief. Kansas Water Well Contractor's License No. 1561 This Water Well Record was completed on (mo/day/yr) 7/3/95 under the business name of Hayne, Inc by (signature) Steven R Mitchell