

CORRECTION(S) TO WATER WELL RECORD (WWC-5)

(to rectify lacking or incorrect information)

Location listed as:

Section-Township-Range: 15-355-13EFraction ($\frac{1}{4}$ $\frac{1}{4}$ $\frac{1}{4}$): None GivenCounty: Chautauqua

Location changed to:

15-355-13ESW NE NWOther changes: Initial statements: No county givenChanged to: Chautauqua County

Comments:

verification method: Legal description, well owner's address, position on plat map, and Caney 1:24,000 topo. map.initials: DRD date: 7/16/2003submitted by: Kansas Geological Survey, Data Resources Library, 1930 Constant Ave., Lawrence, KS 66047-3726
to: Kansas Dept of Health & Environment, Bureau of Water, 1000 SW Jackson, Suite 420, Topeka, KS 66612-1367.

1 LOCATION OF WATER WELL:		Fraction	Section Number	Township Number	Range Number
County:		$\frac{1}{4}$	$\frac{1}{4}$ 15	T 35 S	R 13 E

Distance and direction from nearest town or city street address of well if located within city:


2] WATER WELL OWNER: EARL Redding JR.
RR#, St. Address, Box # : T-Roy-R 149 County Road 32
City, State, ZIP Code : CANEY, KS. 67533

Board of Agriculture, Division of Water Resources
Application Number:

3	LOCATE WELL'S LOCATION WITH	4	DEPTH OF COMPLETED WELL. <u>100</u> ft. ELEVATION:
---	-----------------------------	---	--

AN "X" IN SECTION BOX:

4 DEPTH OF COMPLETED WELL. 100 ft. ELEVATION:

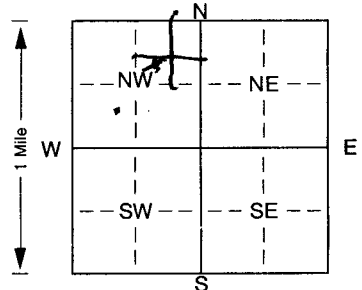

Depth(s) Groundwater Encountered 1. 55 ft. 2. 70 ft. 3. _____ ft.
WELL'S STATIC WATER LEVEL _____ ft. below land surface measured on mo/day/yr 05-2

Pump test data: Well water was ft. after hours pumping gpm
 Est. Yield 2 1/2 gpm: Well water was ft. after hours pumping gpm
 Bore Hole Diameter. 8 in. to 100 ft., and in. to ft.
 WELL WATER TO BE USED AS: 5 Public water supply 8 Air conditioning 11 Injection well
Domestic 3 Feedlot 6 Oil field water supply 9 Dewatering 12 Other (Specify below)
 2 Irrigation 4 Industrial 7 Domestic (lawn & garden) 10 Monitoring well

Was a chemical/bacteriological sample submitted to Department? Yes. No. ; If yes, mo/day/hrs sample was submitted
Water Well Disinfected? Yes ☒ No ☐

5	TYPE OF BLANK CASING USED
---	---------------------------

5 Wrought iron 8 Concrete tile CASING JOINTS: Glued. Clamped.

1 Steel	3 RMP (SR)	6 Asbestos-Cement	9 Other (specify below)	Welded
2 PVC	4 ABS	7 Fiberglass		Threaded

Blank casing diameter . . . 5 . . . in. to . . . 1.00 . . . ft., Dia . . . in. to . . . ft., Dia . . . in. to . . . ft.
Casing height above land surface . . . in., weight . . . 160 . . . lbs./ft. Wall thickness or gauge No.

TYPE OF SCREEN OR PERFORATION MATERIAL:

1 Steel	3 Stainless steel	5 Fiberglass	8 RMP (SR)	11 Other (specify)
2 Brass	4 Galvanized steel	6 Concrete tile	9 ABS	12 None used (open hole)

SCREEN OR PERFORATION OPENINGS ARE:

1 Continuous slot 3 Mill slot 6 Wire wrapped 9 Drilled holes
2 Louvered shutter 4 Key punched 7 Torch cut 10 Other (specify) ft.

SCREEN-PERFORATED INTERVALS: From 100 ft. to 80 ft. From 10 ft. to 40 ft.
From ft. to ft. From ft. to ft.

GRAVEL PACK INTERVALS: From ft. to ft., From ft. to ft.
From ft. to ft., From ft. to ft.
From ft. to ft., From ft. to ft.

6 GROUT MATERIAL: 1 Neat cement 2 Cement grout 3 Bentonite 4 Other

Grout Intervals: From 25 ft. to 30 ft. From _____ ft. to _____ ft. From _____ ft. to _____ ft.

What is the nearest source of possible contamination:

1 Septic tank	4 Lateral lines	7 Pit privy	10 Investigate pond	14 Abandoned water well
2 Sewer lines	5 Cess pool	8 Sewage lagoon	11 Fuel storage	15 Oil well/Gas well
3 Watertight sewer lines	6 Seepage pit	9 Feedyard	12 Fertilizer storage	16 Other (specify below)
			13 Insecticide storage	

Direction from well? _____ How many feet? 100

FROM	TO	LITHOLOGIC LOG	FROM	TO	PLUGGING INTERVALS
0	1	Soil			
1	10	5710 STONE			
10	30	CH21			
30	38	SH21e			
38	40	limo			
40	55	SH21e			
55	57	limo			
57	70	SH21e			
70	77	sand			
77	100	SH21e			

7) CONTRACTOR'S OR LANDOWNER'S CERTIFICATION: This water well was (1) constructed, (2) reconstructed, or (3) plugged under my jurisdiction and was completed on (mo/day/year) 5-2-03 and this record is true to the best of my knowledge and belief. Kansas Water Well Contractor's Licence No. 512 This Water Well Record was completed on (mo/day/yr) 5-5-03 under the business name of Jeffrey Well Drilling by (signature) Jeffrey