


1 LOCATION OF WATER WELL: Fraction **SE 1/4 NW 1/4 NW 1/4** Section Number **3** Township Number **T 35 S** Range Number **R 16** **(EM)**
 County: **Montgomery**
 Distance and direction from nearest town or city street address of well if located within city?
1008 Siggins Street, Coffeyville, Kansas

2 WATER WELL OWNER: **Crescent Oil Company**
 RR#, St. Address, Box # : **P.O. Box 667** Board of Agriculture, Division of Water Resources
 City, State, ZIP Code : **Independence, Kansas 67301** Application Number:

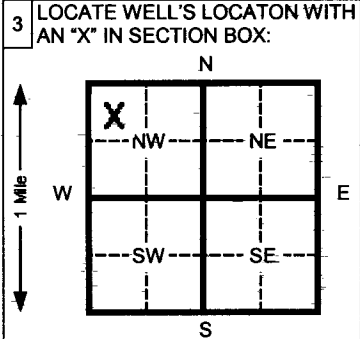

4 DEPTH OF COMPLETED WELL **13.0** ft. ELEVATION:
 Depth(s) Groundwater Encountered 1 **12.5** ft. 2 _____ ft. 3 _____ ft.
 WELL'S STATIC WATER LEVEL **0.85** ft. below land surface measured on mo/day/yr
 Pump test data: Well water was _____ ft. after _____ hours pumping _____ gpm
 Est. Yield **NA** gpm: Well water was _____ ft. after _____ hours pumping _____ gpm
 Bore Hole Diameter **8.5** in. to **13.0** ft. and _____ in. to _____ ft.
 WELL WATER TO BE USED AS: 5 Public water supply 8 Air conditioning 11 Injection well
 1 Domestic 3 Feed lot 6 Oil field water supply 9 Dewatering 12 Other (Specify below)
 2 Irrigation 4 Industrial 7 Lawn and garden (domestic) **10 Monitoring well**
 Was a chemical/bacteriological sample submitted to Department? Yes _____ No **X** If yes, mo/day/yr sample was submitted
 Water Well Disinfected? Yes _____ No **X**

5 TYPE OF BLANK CASING USED: 5 Wrought Iron 8 Concrete tile CASING JOINTS: Glued _____ Clamped _____
 1 Steel 3 RMP (SR) 6 Asbestos-Cement 9 Other (specify below) Welded _____
2 PVC 4 ABS 7 Fiberglass Threaded **X**
 Blank casing diameter **2.375** in. to **5.0** ft., Dia _____ in. to _____ ft., Dia _____ in. to _____ ft.
 Casing height above land surface **Flush Mount** in., weight _____ lbs./ft. Wall thickness or gauge No. **Schedule 40**
 TYPE OF SCREEN OR PERFORATION MATERIAL: **7** PVC 10 Asbestos-cement
 1 Steel 3 Stainless steel 5 Fiberglass 8 RMP (SR) 11 Other (specify) _____
 2 Brass 4 Galvanized steel 6 Concrete tile 9 ABS 12 None used (open hole)
 SCREEN OR PERFORATION OPENINGS ARE: 5 Gauzed wrapped 8 Saw cut 11 None (open hole)
 1 Continuous slot **3** Mill slot 6 Wire wrapped 9 Drilled holes
 2 Louvered shutter 4 Key punched 7 Torch cut 10 Other (specify) _____
 SCREEN-PERFORATED INTERVALS: From **13.0** ft. to **5.0** ft. From _____ ft. to _____ ft.
 GRAVEL PACK INTERVALS: From **13.0** ft. to **3.0** ft. From _____ ft. to _____ ft.
 From _____ ft. to _____ ft. From _____ ft. to _____ ft.

6 GROUT MATERIAL: 1 Neat cement **2** Cement grout **3** Bentonite 4 Other _____
 Grout Intervals From **0.0** ft. to **1.0** ft. From **1.0** ft. to **3.0** ft. From _____ ft. to _____ ft.
 What is the nearest source of possible contamination:
 1 Septic tank 4 Lateral lines 7 Pit privy **11** Fuel storage (former) 14 Abandoned water well
 2 Sewer lines 5 Cess pool 8 Sewage lagoon 12 Fertilizer storage 15 Oil well/ Gas well
 3 Watertight sewer lines 6 Seepage pit 9 Feedyard 13 Insecticide storage 16 Other (specify below) _____
 Direction from well? **West-southwest** How many feet? **115**

FROM	TO	CODE	LITHOLOGIC LOG
0.0	0.5		Asphalt
0.5	4.0		Red brown very silty clay, laminated, iron oxide stained, firm, moist
4.0	8.0		Dark brown-gray brown very silty clay, laminated, some 1/8" sub-rounded gravel, firm, moist
8.0	13.0		Gray brown-red brown very silty clay, friable-slightly hard, moist-dry
13.0			Limestone
Exception to K.A.R. 28-30-6(b) (1) and (e) approved by D. Taylor, KDHE-BOW.			

7 CONTRACTOR'S OR LANDOWNER'S CERTIFICATION: This water well was **1** constructed, (2) reconstructed, or (3) plugged under my jurisdiction and was completed on (mo/day/yr) **03/05/07** and this record is true to the best of my knowledge and belief. Kansas
 Water Well Contractor's License No. **692** This Water Well Record was completed on (mo/day/yr) **04/01/07**
 under the business name of **Quad State Services, Inc.** by (signature) _____
 INSTRUCTIONS: Please fill in blanks and circle the correct answers. Send three copies to Kansas Department of Health and Environment, Bureau of Water, 1000 S/W Jackson St., Ste. 420, Topeka, Kansas 66612-1367. Telephone: 913-296-5545. Send one to WATER WELL OWNER and retain one for your records.

OFFICE USE ONLY

T

R

SEC