


1	LOCATION OF WATER WELL: County: <u>Montgomery</u>	Fraction <u>N2 NE NE</u> <u>1/4 1/4 1/4</u>	Section Number	Township Number	Range Number	EW
---	--	---	----------------	-----------------	--------------	----

Distance and direction from nearest town or city street address of well if located within city?

2	WATER WELL OWNER: RR #, St. Address, Box #: City, State, ZIP Code :	<u>Coffeyville Resources</u> <u>Refining &amp; Marketing LLC</u> <u>803 E 9th</u>	<u>Coffeyville, KS</u> Board of Agriculture, Division of Water Resources Application Number:
---	---	---	--

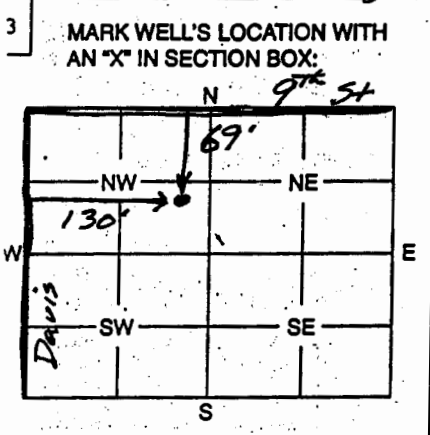

4	DEPTH OF WELL ..... <u>14'6"</u> ..... ft.
	WELL'S STATIC WATER LEVEL ..... <u>13'</u> ..... ft.
	WELL WAS USED AS:
	<input checked="" type="radio"/> Domestic <input type="radio"/> Irrigation <input type="radio"/> Feedlot <input type="radio"/> Industrial <input type="radio"/> Public Water Supply <input type="radio"/> Oil Field Water Supply <input type="radio"/> Domestic (Lawn & Garden) <input type="radio"/> Air Conditioning <input type="radio"/> Dewatering <input type="radio"/> Monitoring Well <input type="radio"/> Injection Well <input type="radio"/> Other .....
	Was a chemical / bacteriological sample submitted to Department? Yes ..... No <input checked="" type="checkbox"/> ..... If yes, mo/day/yr sample was submitted .....
	Water Well Disinfected: Yes <input checked="" type="checkbox"/> No .....

5 TYPE OF BLANK CASING USED:

1 Steel	3 RMP (SR)	5 Wrought	7 Fiberglass	9 Other (Specify below)
2 PVC	4 ABS	6 Asbestos-Cement	8 Concrete Tile	

Blank casing diameter 3'6" in. Was casing pulled? Yes  No ..... If yes, how much Full Depth

Casing height above or below land surface ..... in.

3 GROUT PLUG MATERIAL: 1 Neat cement 2 Cement grout 3 Bentonite  Other Flowable Fill

Grout Plug Intervals: From ..... ft. to ..... ft.; From ..... ft. to ..... ft.; From ..... to ..... ft.

What is the nearest source of possible contamination:

1 Septic tank	6 Seepage pit	11 Fuel storage	16 Other (specify below)
2 Sewer lines	7 Pit privy	12 Fertilizer storage	
3 Watertight sewer lines	8 Sewage lagoon	13 Insecticide storage	
4 Lateral lines	9 Feedyard	14 Abandoned water well	
5 Cess pool	10 Livestock pens	15 Oil well/Gas well	

Direction from well? ..... How many feet? .....

FROM	TO	PLUGGING MATERIALS
<u>14'6"</u>	<u>13'</u>	<u>Chlorinated Gravel</u>
<u>13'</u>	<u>3'6"</u>	<u>Native Soil / Clay</u>
<u>3'6"</u>	<u>3'</u>	<u>Flowable Fill</u>
<u>3'</u>	<u>Grade</u>	<u>Native Soil / Clay</u>

CONTRACTOR'S OF LANDOWNER'S CERTIFICATION: This water well was plugged under my jurisdiction and was completed on (mo/day/year) 12/2012 and this record is true to the best of my knowledge and belief. Kansas Water Well Contractor's License No. .... This Water Well Record was completed on (mo/day/year) ..... under the business name of ..... by (signature) [Signature]