


1 LOCATION OF WATER WELL:	Fraction NE NW NE ¼ ¼ ¼	Section Number	Township Number	Range Number
---------------------------	--------------------------------------	----------------	-----------------	--------------

County: **MONTGOMERY**

E/W

Distance and direction from nearest town or city street address of well if located within city?
Coffeyville Resources Refining & Marketing LLC

2 WATER WELL OWNER: **Coffeyville, KS.**
 RR #, St. Address, Box #: **607 E 9TH**
 City, State, ZIP Code : **Coffeyville, KS.**
 Board of Agriculture, Division of Water Resources
 Application Number:

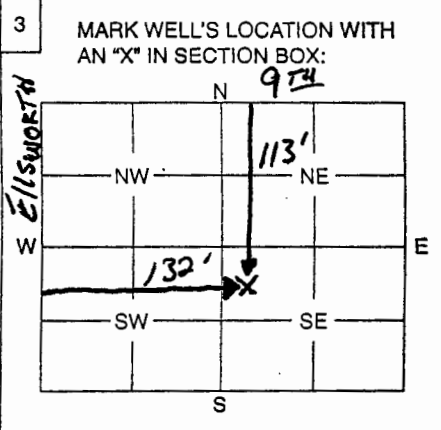

4 DEPTH OF WELL **15'** ft.
 WELL'S STATIC WATER LEVEL **13'5"** ft.
 WELL WAS USED AS:

<input checked="" type="radio"/> 1 Domestic	5 Public Water Supply	9 Dewatering
2 Irrigation	6 Oil Field Water Supply	10 Monitoring Well
3 Feedlot	7 Domestic (Lawn & Garden)	11 Injection Well
4 Industrial	8 Air Conditioning	12 Other

Was a chemical / bacteriological sample submitted to Department? Yes No
 If yes, mo/day/yr sample was submitted

Water Well Disinfected: Yes No

5 TYPE OF BLANK CASING USED:

1 Steel	3 RMP (SR)	5 Wrought	7 Fiberglass	<input checked="" type="radio"/> 9 Other (Specify below) BRICK
2 PVC	4 ABS	6 Asbestos-Cement	8 Concrete Tile	

Blank casing diameter **4'4"** in. Was casing pulled? Yes No If yes, how much **TOTAL**

Casing height above or below land surface in.

6 GROUT PLUG MATERIAL: 1 Neat cement 2 Cement grout 3 Bentonite 4 Other **FLOWABLE FILL**

Grout Plug Intervals: From ft. to ft., From ft. to ft., From to ft.

What is the nearest source of possible contamination:

1 Septic tank	6 Seepage pit	11 Fuel storage	16 Other (specify below)
<input checked="" type="radio"/> 2 Sewer lines	7 Pit privy	12 Fertilizer storage	
3 Watertight sewer lines	8 Sewage lagoon	13 Insecticide storage	
4 Lateral lines	9 Feedyard	14 Abandoned water well	
5 Cess pool	10 Livestock pens	15 Oil well/Gas well	

Direction from well? **SOUTH** How many feet? **600'**

FROM	TO	PLUGGING MATERIALS
	15'	Excavate Completely
15'	13'5"	CHLORINATED ROCK
13'5"	3'6"	Compacted Soil
3'6"	3'	Flowable Fill
3'	Grade	Compacted Soil

7 CONTRACTOR'S OF LANDOWNER'S CERTIFICATION: This water well was plugged under my jurisdiction and was completed on (mo/day/year) and this record is true to the best of my knowledge and belief. Kansas Water Well Contractor's License No. **2/29/08** This Water Well Record was completed on (mo/day/year)
 by (signature) *[Signature]* under the business name of

INSTRUCTIONS: Use typewriter or ball point pen. Please press firmly and print clearly. Please fill in blanks, underline or circle the correct answers. Send top three copies to Kansas Department of Health and Environment, Bureau of Water, Geology Section, 1000 SW Jackson St., Ste. 420, Topeka, Kansas 66612-1367. Telephone: 785/296-5522. Send one to Water Well Owner and retain one for your records.