


1 LOCATION OF WATER WELL: County: Montgomery Fraction NW 1/4 SW 1/4 1/4 Section Number 17 Township Number 35 Range Number 16 DWL

Distance and direction from nearest town or city street address of well if located within city?  
Approximately 3 miles south of Dearing, Kansas, on CR 3900;  
thence 1.1 miles east on CR 1250 (south side)

2 WATER WELL OWNER: GRETA REXWINKLE Global Positioning Systems (decimal degrees, min. of 4 digits  
 RR#, St. Address, Box #: 4110 CR 1250  
 Latitude: \_\_\_\_\_  
 Longitude: \_\_\_\_\_  
 Elevation: \_\_\_\_\_  
 City, State ZIP Code: COFFEYVILLE, KANSAS 67337  
 Datum: \_\_\_\_\_  
 Data Collection Method: \_\_\_\_\_

3 MARK WELL'S LOCATION WITH AN "X" IN SECTION BOX:

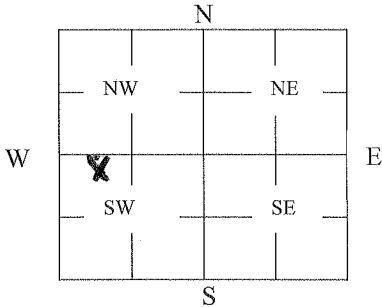

4 DEPTH OF WELL 29' ft.  
 WELL'S STATIC WATER LEVEL 7 ft.

WELL WAS USED AS:

- |              |   |                   |
|--------------|---|-------------------|
| 1 Domestic   | 5 Public Water Supply                                     | 9 Dewatering      |
| 2 Irrigation | 6 Oil Field Water Supply                                  | 10 Monitoring     |
| 3 Feedlot    | <input checked="" type="radio"/> Domestic (Lawn & Garden) | 11 Injection Well |
| 4 Industrial | 8 Air Conditioning  | 12 Other _____    |

Was a chemical/bacteriological sample submitted to Department? Yes \_\_\_\_\_ No \_\_\_\_\_

5 TYPE OF BLANK CASING USED:  
 1 Steel    3 RMP (SR)    5 Wrought    7 Fiberglass    9 Other (Specify below) \_\_\_\_\_  
 2 PVC    4 ABS    6 Asbestos-Cement    8 Concrete Tile

Blank casing diameter 6 in. Was casing pulled? Yes  No  If yes, how much 54"  
 Casing height above or below land surface -78 in.

6 GROUT PLUG MATERIAL:  1 Neat cement    2 Cement grout    3 Bentonite    4 Other \_\_\_\_\_  
 Grout Plug Intervals: From 7' ft. to 4' ft., From \_\_\_\_\_ ft. to \_\_\_\_\_ ft., From \_\_\_\_\_ to \_\_\_\_\_ ft.

What is the nearest source of possible contamination:

- |  |                   |                         |                                |
|--|-------------------|-------------------------|--------------------------------|
| <input checked="" type="radio"/> 1 Septic tank | 6 Seepage pit     | 11 Fuel Storage         | 16 Other (specify below) _____ |
| 2 Sewer lines                                  | 7 Pit privy       | 12 Fertilizer storage   | _____                          |
| 3 Watertight sewer lines                       | 8 Sewage lagoon   | 13 Insecticide storage  | _____                          |
| 4 Lateral lines                                | 9 Feedyard        | 14 Abandoned water well | Direction from well? <u>NE</u> |
| 5 Cess pool                                    | 10 Livestock pens | 15 Oil well/Gas well    | How many feet? <u>50'</u>      |

FROM	TO	PLUGGING MATERIALS	FROM	TO	PLUGGING MATERIALS
<u>29'</u>	<u>7'</u>	<u>Chlorinated GRAVEL</u>			
<u>7'</u>	<u>4'</u>	<u>NEAT CEMENT</u>			
<u>4'</u>	<u>0</u>	<u>Compacted Clay</u>			

7 CONTRACTOR'S OR LANDOWNER'S CERTIFICATION: This water well was plugged under my jurisdiction and was completed on (mo/day/year) 1/27/12 and this record is true to the best of my knowledge and belief, Kansas Water Well Contractor's License No. \_\_\_\_\_ This Water Well Record was completed on (mo/day/year) 1/27/12 under the business name of Brian M. Gully by (signature)

INSTRUCTIONS: Use typewriter or ballpoint pen. Please press firmly and print clearly. Please fill in blanks, underline or circle the correct answers. Send top three copies to Kansas Department of Health and Environment, Bureau of Water, Geology Section, 1000 SW Jackson St., Ste. 420, Topeka, Kansas 66612-1367. Telephone: 785/296-5522. Send one to Water Well Owner and retain one for your records. Visit us at <http://www.kdheks.gov/geo/waterwells>.