


1 LOCATION OF WATER WELL: Fraction SE 1/4 NE 1/4 NE 1/4 Section Number 1 Township Number T 35 S Range Number R 16 E/W
 County: Montgomery

Distance and direction from nearest town or city street address of well if located within city?
1002 Sunflower - Coffeyville

2 WATER WELL OWNER: Jerry Shankles MWI
 RR#, St. Address, Box #: 1002 Sunflower Board of Agriculture, Division of Water Resources
 City, State, ZIP Code: Coffeyville, KS Application Number:

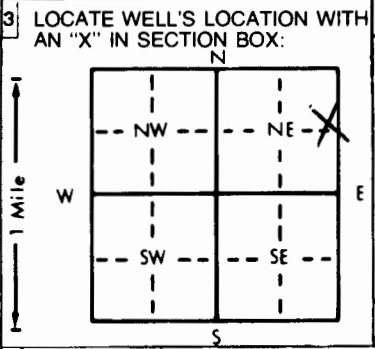

4 DEPTH OF COMPLETED WELL: 19.5 ft. ELEVATION:
 Depth(s) Groundwater Encountered 1. ~14.5' ft. 2. _____ ft. 3. _____ ft.
 WELL'S STATIC WATER LEVEL _____ ft. below land surface measured on mo/day/yr
 Pump test data: Well water was _____ ft. after _____ hours pumping _____ gpm
 Est. Yield _____ gpm: Well water was _____ ft. after _____ hours pumping _____ gpm
 Bore Hole Diameter _____ in. to _____ ft., and _____ in. to _____ ft.
 WELL WATER TO BE USED AS: 5 Public water supply 8 Air conditioning 11 Injection well
 1 Domestic 3 Feedlot 6 Oil field water supply 9 Dewatering 12 Other (Specify below)
 2 Irrigation 4 Industrial 7 Lawn and garden only 10 Monitoring well
 Was a chemical/bacteriological sample submitted to Department? Yes _____ No (X) If yes, mo/day/yr sample was submitted
 Water Well Disinfected? Yes _____ No (X)

5 TYPE OF BLANK CASING USED: 2 PVC 3 RMP (SR) 4 ABS 5 Wrought iron 8 Concrete tile 9 Other (specify below) CASING JOINTS: Glued _____ Clamped _____
2 Steel 6 Asbestos-Cement 7 Fiberglass Welded
2 PVC 4 ABS 7 Fiberglass Threaded
 Blank casing diameter 2 in. to 9 ft. Dia _____ in. to _____ ft. Dia _____ in. to _____ ft.
 Casing height above land surface 0 in., weight _____ lbs./ft. Wall thickness or gauge No. _____
 TYPE OF SCREEN OR PERFORATION MATERIAL: 7 PVC 10 Asbestos-cement
 1 Steel 3 Stainless steel 5 Fiberglass 8 RMP (SR) 11 Other (specify) _____
 2 Brass 4 Galvanized steel 6 Concrete tile 9 ABS 12 None used (open hole)
 SCREEN OR PERFORATION OPENINGS ARE: 5 Gauzed wrapped 8 Saw cut 11 None (open hole)
 1 Continuous slot 3 Mill slot 6 Wire wrapped 9 Drilled holes
 2 Louvered shutter 4 Key punched 7 Torch cut 10 Other (specify) _____
 SCREEN-PERFORATED INTERVALS: From 9 ft. to 19 ft., From _____ ft. to _____ ft.
 From _____ ft. to _____ ft., From _____ ft. to _____ ft.
 GRAVEL PACK INTERVALS: From 7 ft. to 19.5 ft., From _____ ft. to _____ ft.
 From _____ ft. to _____ ft., From _____ ft. to _____ ft.

6 GROUT MATERIAL: 1 Neat cement 2 Cement grout 3 Bentonite 4 Other _____
 Grout Intervals: From 0 ft. to 1.5 ft., From 1.5 ft. to 7 ft., From _____ ft. to _____ ft.
 What is the nearest source of possible contamination:
 1 Septic tank 4 Lateral lines 7 Pit privy 10 Livestock pens 14 Abandoned water well
 2 Sewer lines 5 Cess pool 8 Sewage lagoon 11 Fuel storage 15 Oil well/Gas well
 3 Watertight sewer lines 6 Seepage pit 9 Feedyard 12 Fertilizer storage 16 Other (specify below)
USTS
 Direction from well? _____ How many feet? _____

FROM	TO	LITHOLOGIC LOG	FROM	TO	PLUGGING INTERVALS
<u>0</u>	<u>3</u>	<u>Clay, Dk Brn</u>			
<u>3</u>	<u>6</u>	<u>Clay, Lt. Brn-Red w/ fine sand</u>			
<u>6</u>	<u>14</u>	<u>Clay, Lt. Brn w/ fine-med sand</u>			
<u>14</u>	<u>19</u>	<u>Sand, fine-med w/ silt</u>			
					<u>Flushmount waiver by D. Taylor</u>

7 CONTRACTOR'S OR LANDOWNER'S CERTIFICATION: This water well was (1) constructed, (2) reconstructed, or (3) plugged under my jurisdiction and was completed on (mo/day/year) 8/12/97 and this record is true to the best of my knowledge and belief. Kansas Water Well Contractor's License No. 483 This Water Well Record was completed on (mo/day/year) 9/25/97 under the business name of T.E.S.T by (signature) Bob Robinson by LL

OFFICE USE ONLY
T
R
EW
SEC.
1/4
1/4
1/4