


1 LOCATION OF WATER WELL:	Fraction	Section Number	Township Number	Range Number
County: Montgomery	SE 1/4 SW 1/4 NW 1/4	12	T 35 S	R 16 E

Distance and direction from nearest town or city street address of well if located within city?
Approx. 18' S, 20' W of SWC of Adams St. and Walnut St. – Coffeyville

2 WATER WELL OWNER:	EI Paso Merchant Energy-Petroleum Co.		
RR#, St. Address, Box #	2 N. Nevada	Board of Agriculture, Division of Water Resources	
City, State, ZIP Code	Colorado Springs, CO 80903	Application Number:	

3 LOCATE WELL'S LOCATION WITH AN "X" IN SECTION BOX:

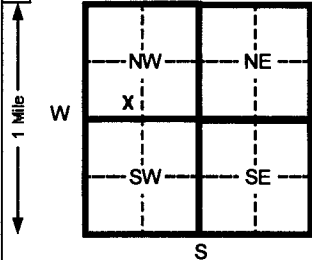

4 DEPTH OF COMPLETED WELL	20.5 ft.	ELEVATION:	723.86 (TOC)
Depth(s) Groundwater Encountered	1 18.5 ft.	2	3
WELL'S STATIC WATER LEVEL	9.13 ft. below TOC	measured on 03/12/14 mo/day/yr	
Pump test data: Well water was		ft. after	hours pumping
Est. Yield	gpm:	Well water was	ft. after
Bore Hole Diameter	8.25 in. to 20.5 ft.	and	in. to
WELL WATER TO BE USED AS:	5 Public water supply 8 Air conditioning 11 Injection well 1 Domestic 3 Feed lot 6 Oil field water supply 9 Dewatering 12 Other (Specify below) 2 Irrigation 4 Industrial 7 Lawn and garden (domestic) 10 Monitoring well		
Was a chemical/bacteriological sample submitted to Department?	Yes No X If yes, mo/day/yr sample was submitted		
Water Well Disinfected?	Yes No X		

5 TYPE OF BLANK CASING USED:	5 Wrought Iron	8 Concrete tile	CASING JOINTS:	Glued	Clamped
1 Steel	3 RMP (SR)	6 Asbestos-Cement	9 Other (specify below)	Welded	
2 PVC	4 ABS	7 Fiberglass	Flush		
Blank casing diameter	2 in. to 10.5 ft.	Dia	in. to	ft.	Dia
Casing height above land surface	0 in.	weight	0.703 lbs./ft.	Wall thickness or gauge No.	SCH. 40

TYPE OF SCREEN OR PERFORATION MATERIAL:			7 PVC	10 Asbestos-cement	
1 Steel	3 Stainless steel	5 Fiberglass	8 RMP (SR)	11 Other (specify)	
2 Brass	4 Galvanized steel	6 Concrete tile	9 ABS	12 None used (open hole)	
SCREEN OR PERFORATION OPENINGS ARE:			5 Gauzed wrapped	8 Saw cut	11 None (open hole)
1 Continuous slot	3 Mill slot	6 Wire wrapped	9 Drilled holes		
2 Louvered shutter	4 Key punched	7 Torch cut	10 Other (specify)		
SCREEN-PERFORATED INTERVALS:	From 10.5 ft. to 20.5 ft.	From	ft. to	ft.	ft.
GRAVEL PACK INTERVALS:	From 8.5 ft. to 20.5 ft.	From	ft. to	ft.	ft.

6 GROUT MATERIAL:	1 Neat cement	2 Cement grout	3 Bentonite	4 Other
Grout intervals	From 1 ft. to 8.5 ft.	From	ft. to	ft.

What is the nearest source of possible contamination:

1 Septic tank	4 Lateral lines	7 Pit privy	10 Livestock pens	14 Abandoned water well
2 Sewer lines	5 Cess pool	8 Sewage lagoon	11 Fuel storage	15 Oil well/ Gas well
3 Watertight sewer lines	6 Seepage pit	9 Feedyard	12 Fertilizer storage	16 Other (specify below)
13 Insecticide storage				

Direction from well? How many feet?

FROM	TO	CODE	LITHOLOGIC LOG	FROM	TO	PLUGGING INTERVALS
0	1		Concrete			
1	20.5		Silty Clay, olive-brown to brown			
						Survey Date: 03/21/14
						Northing: 1452102.94
						Easting: 2154335.10

7 CONTRACTOR'S OR LANDOWNER'S CERTIFICATION:	This water well was (1) constructed , (2) reconstructed, or (3) plugged under my jurisdiction and was completed on (mo/day/yr) 03/10/14 and this record is true to the best of my knowledge and belief. Kansas Water Well Contractor's License No. 531 This Water Well Record was completed on (mo/day/yr) 04/16/14 under the business name of GSI Engineering, LLC by (signature) _____	
--	---	--

INSTRUCTIONS: Please fill in blanks and circle the correct answers. Send three copies to Kansas Department of Health and Environment, Bureau of Water, 1000 S W Jackson St., Ste. 420, Topeka, Kansas 66612-1367. Telephone: 913-296-5545. Send one to WATER WELL OWNER and retain one for your records.

OFFICE USE ONLY

T
R

SEC