

1 LOCATION OF WATER WELL: Fraction NW 1/4 NE 1/4 Section Number 4 Township Number T 35 S Range Number R 16 E

Distance and direction from nearest town or city street address of well if located within city? 3303 W. 8th St. - Coffeyville

2 WATER WELL OWNER: KDHE


RR#, St. Address, Box #: 1000 SW Jackson St., Ste. 410

Board of Agriculture, Division of Water Resources

City, State, ZIP Code: Topeka, KS 66612

Application Number:

3 LOCATE WELL'S LOCATION WITH AN 'X' IN SECTION BOX:

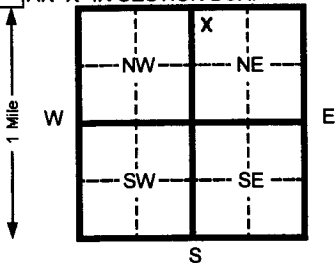

4 DEPTH OF COMPLETED WELL 25 ft. ELEVATION: 745.46 (TOC)

Depth(s) Groundwater Encountered 1 25 ft. 2 13.95 ft. 3 ft.

WELL'S STATIC WATER LEVEL 14.14 ft. below TOC measured on mo/day/yr 05/07/14

Pump test data: Well water was ... ft. after ... hours pumping ... gpm

Est. Yield ... gpm: Well water was ... ft. after ... hours pumping ... gpm

Bore Hole Diameter 8.25 in. to 25 ft. and ... in. to ... ft.

WELL WATER TO BE USED AS: 5 Public water supply 8 Air conditioning 11 Injection well

1 Domestic 3 Feed lot 6 Oil field water supply 9 Dewatering 12 Other (Specify below)

2 Irrigation 4 Industrial 7 Lawn and garden (domestic) 10 Monitoring well

Was a chemical/bacteriological sample submitted to Department? Yes No X If yes, mo/day/yr sample was submitted

Water Well Disinfected? Yes No X

5 TYPE OF BLANK CASING USED:

1 Steel 3 RMP (SR)

2 PVC 4 ABS

Blank casing diameter 2 in. to 10 ft., Dia

Casing height above land surface 0 in., weight 0.703 lbs./ft.

5 Wrought Iron 8 Concrete tile CASING JOINTS: Glued Clamped

6 Asbestos-Cement 9 Other (specify below) Welded

7 Fiberglass Threaded Flush

TYPE OF SCREEN OR PERFORATION MATERIAL: 7 PVC 10 Asbestos-cement

1 Steel 3 Stainless steel 5 Fiberglass 8 RMP (SR) 11 Other (specify)

2 Brass 4 Galvanized steel 6 Concrete tile 9 ABS 12 None used (open hole)

SCREEN OR PERFORATION OPENINGS ARE: 5 Gauzed wrapped 8 Saw cut 11 None (open hole)

1 Continuous slot 3 Mill slot 6 Wire wrapped 9 Drilled holes

2 Louvered shutter 4 Key punched 7 Torch cut 10 Other (specify)

SCREEN-PERFORATED INTERVALS: From 10 ft. to 25 ft.

GRAVEL PACK INTERVALS: From 8 ft. to 25 ft.

6 GROUT MATERIAL: 1 Neat cement 2 Cement grout 3 Bentonite 4 Other

Grout Intervals From 1 ft. to 8 ft.

What is the nearest source of possible contamination: 10 Livestock pens 14 Abandoned water well

1 Septic tank 4 Lateral lines 7 Pit privy 11 Fuel storage 15 Oil well/ Gas well

2 Sewer lines 5 Cess pool 8 Sewage lagoon 12 Fertilizer storage 16 Other (specify below)

3 Watertight sewer lines 6 Seepage pit 9 Feedyard 13 Insecticide storage

Direction from well? How many feet?

Table with columns: FROM, TO, CODE, LITHOLOGIC LOG, FROM, TO, PLUGGING INTERVALS. Rows include Topsoil, Silty Clay, Sandy Clay, and Survey Date/Coordinates.

7 CONTRACTOR'S OR LANDOWNER'S CERTIFICATION: This water well was (1) constructed, (2) reconstructed, or (3) plugged under my jurisdiction and was completed on (mo/day/yr) 05/07/14 and this record is true to the best of my knowledge and belief. Kansas

Water Well Contractor's License No. 531 This Water Well Record was completed on (mo/day/yr) 06/16/14

under the business name of GSI Engineering, LLC by (signature) Sarah Wad

INSTRUCTIONS: Please fill in blanks and circle the correct answers. Send three copies to Kansas Department of Health and Environment, Bureau of Water, 1000 S W Jackson St., Ste. 420, Topeka, Kansas 66612-1367. Telephone: 913-296-5545. Send one to WATER WELL OWNER and retain one for your records.

OFFICE USE ONLY

T

R

SEC