


| | | | | |
|---|--|----------------------------|----------------------------------|--|
| 1 LOCATION OF WATER WELL: County: <u>Montgomery</u> | Fraction <u>SW 1/4 SE 1/4 NE 1/4 NE 1/4</u> | Section Number <u>3</u> | Township Number <u>T 35 S</u> | Range Number <u>16</u> <input checked="" type="checkbox"/> E <input type="checkbox"/> W |
|---|--|----------------------------|----------------------------------|--|

Street/Rural Address of Well Location; if unknown, distance & direction from nearest town or intersection: If at owner's address, check here 1311 W. 11th St. Coffeyville, KS

Global Positioning Systems (GPS) information:
 Latitude: 37.03336 (in decimal degrees)
 Longitude: 95.63862 (in decimal degrees)
 Elevation: 739.11
 Horizontal Datum: WGS84, NAD83, NAD27
 Collection Method:

2 WATER WELL OWNER: Sunshine Fuel, LLC
 RR#, St. Address, Box #: 2751 SW Barnes Ave
 City, State ZIP Code: Independence, KS 67301

GPS unit (Make/Model: _____)
 Digital Map/Photo, Topographic Map, Land Survey
 Est. Accuracy: < 3 m, 3-5 m, 5-15 m, > 15 m

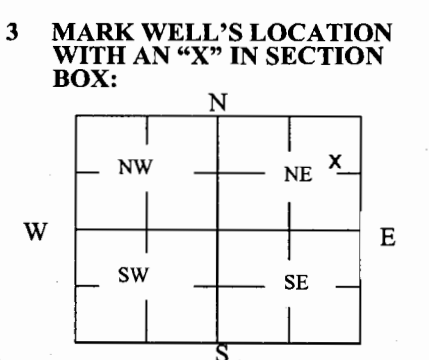

4 DEPTH OF WELL 15.03 ft.
 WELL'S STATIC WATER LEVEL 3.58 ft.
 WELL WAS USED AS:
 Domestic Public Water Supply Dewatering
 Irrigation Oil Field Water Supply Monitoring
 Feedlot Domestic (Lawn & Garden) Injection Well
 Industrial Air Conditioning Other _____
 Was a chemical/bacteriological sample submitted to Department? Yes No

5 TYPE OF BLANK CASING USED:

Steel RMP (SR) Wrought Fiberglass Other (Specify below)
 PVC ABS Asbestos-Cement Concrete Tile

Blank casing diameter 2 in. Was casing pulled? Yes No If yes, how much 3 FT
 Casing height above or below land surface 36 in.

6 GROUT PLUG MATERIAL: Neat cement Cement grout Bentonite Other Soil


Grout Plug Intervals: From ¹ 15.03 ft. to 3.0 ft., From ² 3.0 ft. to 0.5 ft., From _____ ft. to _____ ft.

What is the nearest source of possible contamination:

| | | | |
|---|---|--|--|
| <input type="checkbox"/> Septic tank | <input type="checkbox"/> Seepage pit | <input checked="" type="checkbox"/> Fuel storage | <input type="checkbox"/> Other (specify below) |
| <input type="checkbox"/> Sewer lines | <input type="checkbox"/> Pit privy | <input type="checkbox"/> Fertilizer storage | |
| <input type="checkbox"/> Watertight sewer lines | <input type="checkbox"/> Sewage lagoon | <input type="checkbox"/> Insecticide storage | |
| <input type="checkbox"/> Lateral lines | <input type="checkbox"/> Feedyard | <input type="checkbox"/> Abandoned water well | Direction from well? <u>S/SW</u> |
| <input type="checkbox"/> Cess pool | <input type="checkbox"/> Livestock pens | <input type="checkbox"/> Oil well/Gas well | How many feet? <u>350</u> |

| FROM | TO | PLUGGING MATERIALS | FROM | TO | PLUGGING MATERIALS |
|-------|----|--------------------------|------|----|--------------------|
| 3 | 0 | Compact silt/clay soil | | | |
| 15.03 | 3 | Hydrated Bentonite Chips | | | |
| | | | | | |
| | | | | | |
| | | | | | |
| | | | | | |

7 CONTRACTOR'S OR LANDOWNER'S CERTIFICATION: This water well was plugged under my jurisdiction and was completed on (mo/day/year) 3/28/17 and this record is true to the best of my knowledge and belief. Kansas Water Well Contractor's License No. 585. This Water Well Record was completed on (mo/day/year) 4/3/17 under the business name of Associated Environmental, Inc. by (signature) [Signature]

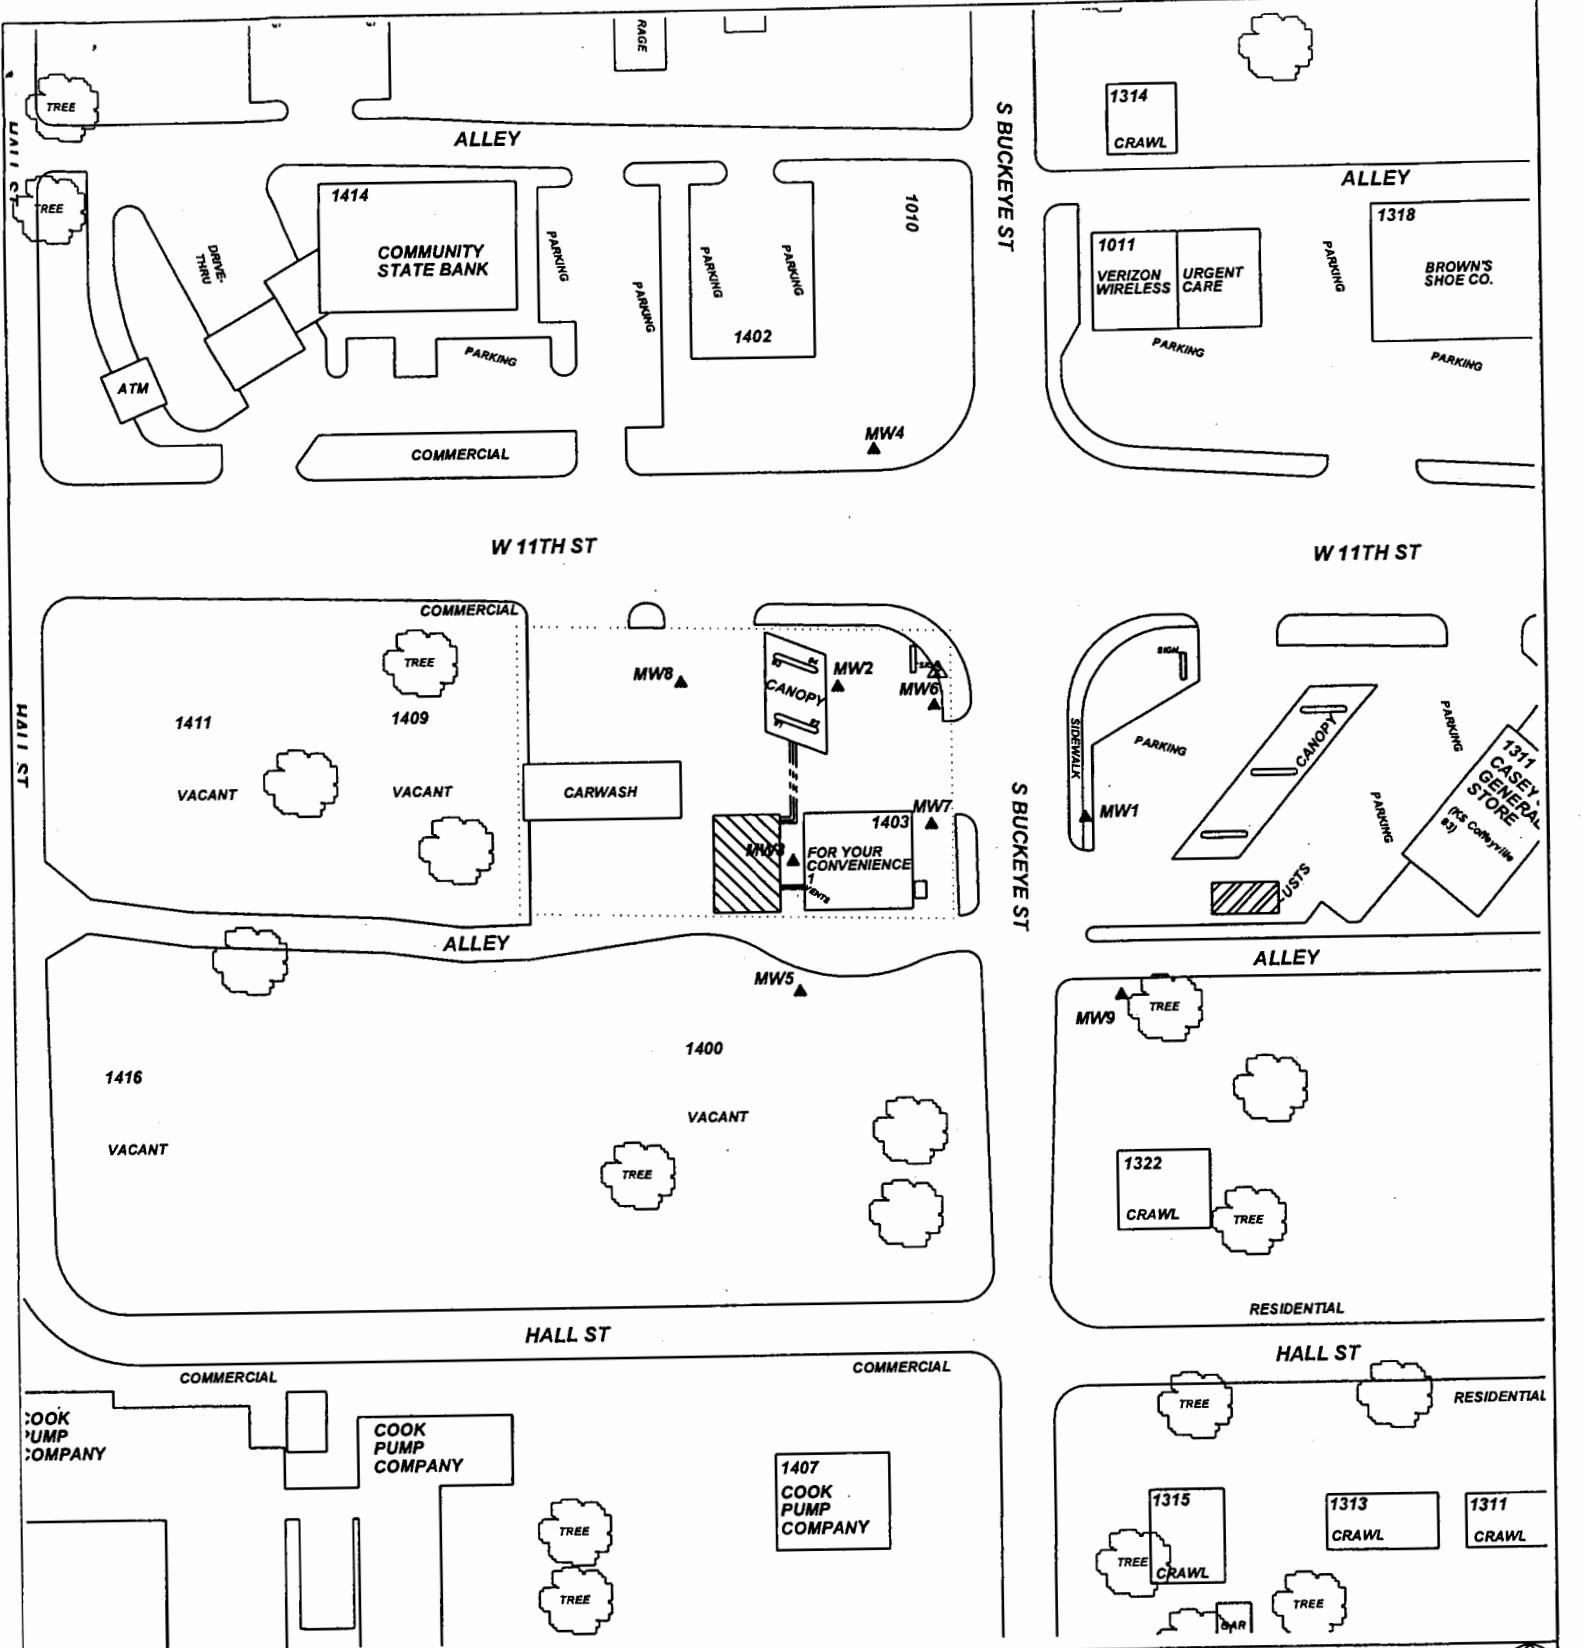

PROJECT: FOR YOUR CONVENIENCE 1

ADDRESS: 1401 W. 11TH ST.

LOCATION: COFFEYVILLE, KS

DRAWN BY: B. SCOTT **DATE:** 04/08/2015

REVISED BY: C. ROE **DATE:** 05/10/2015

AEI JOB #: TF483 **KDHE JOB #:** U3-063-14719

TITLE:

Site Map

ASSOCIATED ENVIRONMENTAL INC.

- LEGEND:**
- = Active UST Basin (1-10,000 g. gasoline & 1-10,000 g. diesel) & associated fueling system
 - = Monitor Well
 - = Plugged/Destroyed Well Location
 - = Site Property Boundary
 - = Site Benchmark

SCALE: 1" = 100'

NOTES: