

WATER WELL PLUGGING RECORD Form WWC-5P

KSA 82a-1212 ID NO.

MW6

1 LOCATION OF WATER WELL: County: <u>Montgomery</u>	Fraction <u>SW 1/4 SE 1/4 NE 1/4 NE 1/4</u>	Section Number <u>3</u>	Township Number <u>T 35 S</u>	Range Number <u>16</u> <input checked="" type="checkbox"/> E <input type="checkbox"/> W
---	--	----------------------------	----------------------------------	--

Street/Rural Address of Well Location; if unknown, distance & direction from nearest town or intersection: If at owner's address, check here <input type="checkbox"/> <u>1311 W. 11th St. Coffeyville, KS</u>	Global Positioning Systems (GPS) information: Latitude: <u>37.03303</u> (in decimal degrees) Longitude: <u>95.63844</u> (in decimal degrees) Elevation: <u>739.35</u> Horizontal Datum: <input type="checkbox"/> WGS84, <input checked="" type="checkbox"/> NAD83, <input type="checkbox"/> NAD27 Collection Method: <input type="checkbox"/> GPS unit (Make/Model: _____) <input type="checkbox"/> Digital Map/Photo, <input type="checkbox"/> Topographic Map, <input checked="" type="checkbox"/> Land Survey Est. Accuracy: <input checked="" type="checkbox"/> < 3 m, <input type="checkbox"/> 3-5 m, <input type="checkbox"/> 5-15 m, <input type="checkbox"/> > 15 m
---	--

2 WATER WELL OWNER: <u>Sunshine Fuel, LLC</u> RR#, St. Address, Box #: <u>2751 SW Barnes Ave</u> City, State ZIP Code: <u>Independence, KS 67301</u>	
---	--

3 MARK WELL'S LOCATION WITH AN "X" IN SECTION BOX: <div style="text-align: center;"> N <table border="1" style="margin: auto; border-collapse: collapse;"> <tr> <td style="padding: 5px;">NW</td> <td style="padding: 5px;">NE X</td> </tr> <tr> <td style="padding: 5px;">SW</td> <td style="padding: 5px;">SE</td> </tr> </table> W E S </div>	NW	NE X	SW	SE	4 DEPTH OF WELL <u>15.11</u> ft. WELL'S STATIC WATER LEVEL <u>4.90</u> ft WELL WAS USED AS: <table style="width:100%;"> <tr> <td><input type="checkbox"/> Domestic</td> <td><input type="checkbox"/> Public Water Supply</td> <td><input type="checkbox"/> Dewatering</td> </tr> <tr> <td><input type="checkbox"/> Irrigation</td> <td><input type="checkbox"/> Oil Field Water Supply</td> <td><input checked="" type="checkbox"/> Monitoring</td> </tr> <tr> <td><input type="checkbox"/> Feedlot</td> <td><input type="checkbox"/> Domestic (Lawn & Garden)</td> <td><input type="checkbox"/> Injection Well</td> </tr> <tr> <td><input type="checkbox"/> Industrial</td> <td><input type="checkbox"/> Air Conditioning</td> <td><input type="checkbox"/> Other _____</td> </tr> </table> Was a chemical/bacteriological sample submitted to Department? Yes <input type="checkbox"/> No <input checked="" type="checkbox"/>	<input type="checkbox"/> Domestic	<input type="checkbox"/> Public Water Supply	<input type="checkbox"/> Dewatering	<input type="checkbox"/> Irrigation	<input type="checkbox"/> Oil Field Water Supply	<input checked="" type="checkbox"/> Monitoring	<input type="checkbox"/> Feedlot	<input type="checkbox"/> Domestic (Lawn & Garden)	<input type="checkbox"/> Injection Well	<input type="checkbox"/> Industrial	<input type="checkbox"/> Air Conditioning	<input type="checkbox"/> Other _____
NW	NE X																
SW	SE																
<input type="checkbox"/> Domestic	<input type="checkbox"/> Public Water Supply	<input type="checkbox"/> Dewatering															
<input type="checkbox"/> Irrigation	<input type="checkbox"/> Oil Field Water Supply	<input checked="" type="checkbox"/> Monitoring															
<input type="checkbox"/> Feedlot	<input type="checkbox"/> Domestic (Lawn & Garden)	<input type="checkbox"/> Injection Well															
<input type="checkbox"/> Industrial	<input type="checkbox"/> Air Conditioning	<input type="checkbox"/> Other _____															

5 TYPE OF BLANK CASING USED:

<input type="checkbox"/> Steel	<input type="checkbox"/> RMP (SR)	<input type="checkbox"/> Wrought	<input type="checkbox"/> Fiberglass	<input type="checkbox"/> Other (Specify below) _____
<input checked="" type="checkbox"/> PVC	<input type="checkbox"/> ABS	<input type="checkbox"/> Asbestos-Cement	<input type="checkbox"/> Concrete Tile	

Blank casing diameter 2 in. Was casing pulled? Yes No If yes, how much 3 FT
 Casing height above or below land surface 36 in.

6 GROUT PLUG MATERIAL: Neat cement Cement grout ¹ Bentonite ² Other Soil


Grout Plug Intervals: From ¹ 15.11 ft. to 3.0 ft., From ² 3.0 ft. to 0.5 ft., From _____ ft. to _____ ft.

What is the nearest source of possible contamination:

<input type="checkbox"/> Septic tank	<input type="checkbox"/> Seepage pit	<input checked="" type="checkbox"/> Fuel storage	<input type="checkbox"/> Other (specify below) _____
<input type="checkbox"/> Sewer lines	<input type="checkbox"/> Pit privy	<input type="checkbox"/> Fertilizer storage	
<input type="checkbox"/> Watertight sewer lines	<input type="checkbox"/> Sewage lagoon	<input type="checkbox"/> Insecticide storage	
<input type="checkbox"/> Lateral lines	<input type="checkbox"/> Feedyard	<input type="checkbox"/> Abandoned water well	Direction from well? <u>Southwest</u>
<input type="checkbox"/> Cess pool	<input type="checkbox"/> Livestock pens	<input type="checkbox"/> Oil well/Gas well	How many feet? <u>170</u>

FROM	TO	PLUGGING MATERIALS	FROM	TO	PLUGGING MATERIALS
3	0	Compact silt/clay soil			
15.11	3	Hydrated Bentonite Chips			

7 CONTRACTOR'S OR LANDOWNER'S CERTIFICATION: This water well was plugged under my jurisdiction and was completed on (mo/day/year) 3/28/17 and this record is true to the best of my knowledge and belief. Kansas Water Well Contractor's License No. 585. This Water Well Record was completed on (mo/day/year) 4/3/17 under the business name of Associated Environmental, Inc. by (signature) [Signature]

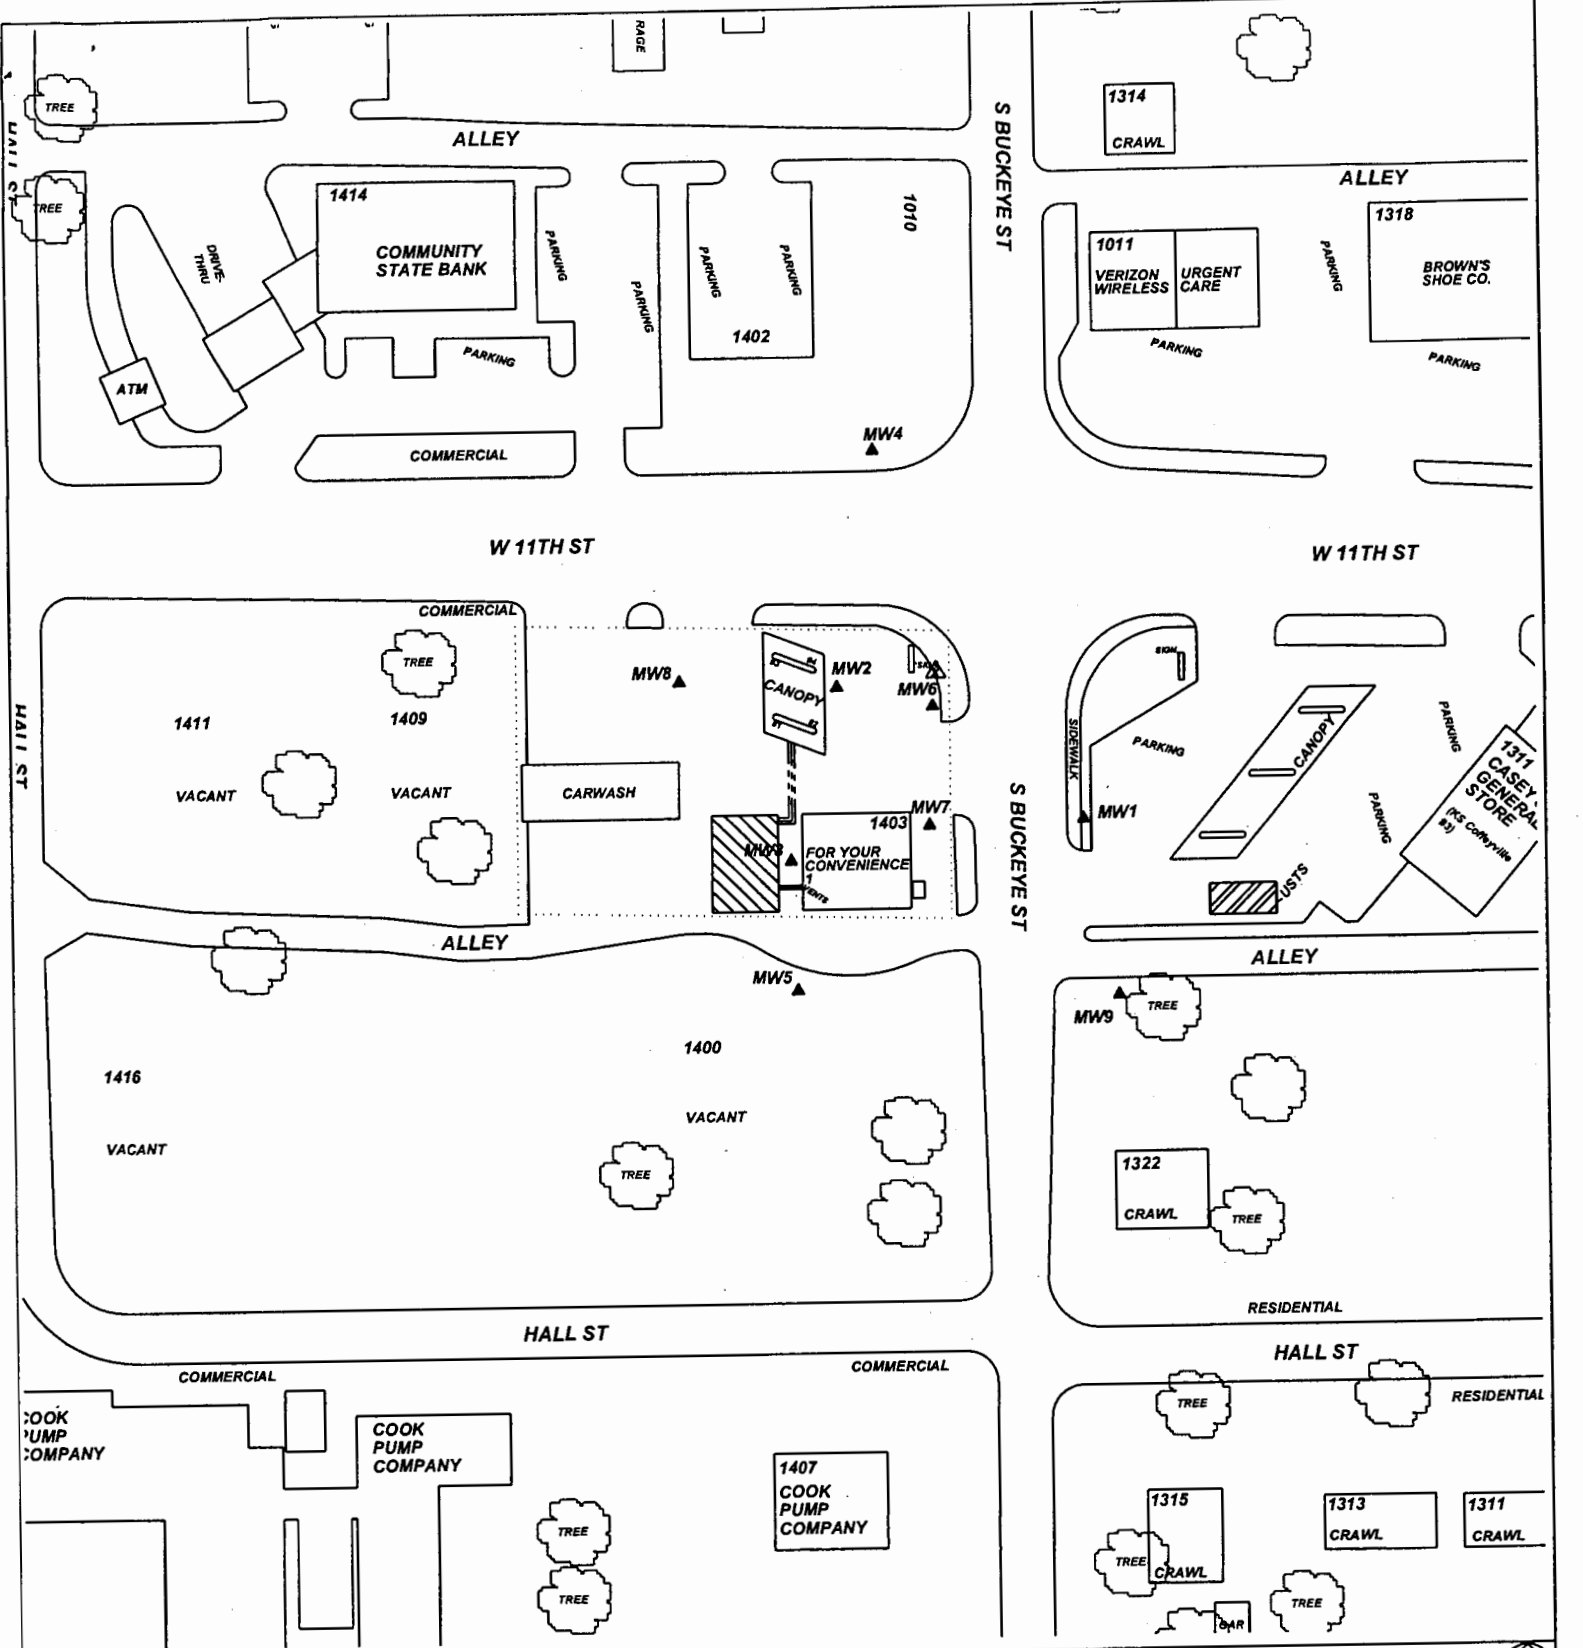

PROJECT: **FOR YOUR CONVENIENCE 1**

ADDRESS: **1401 W. 11TH ST.**

LOCATION: **COFFEYVILLE, KS**

DRAWN BY: **B. SCOTT** DATE: **04/08/2015**

REVISED BY: **C. ROE** DATE: **05/10/2015**

AEI JOB #: **TF483** KDHE JOB #: **U3-063-14719**

TITLE: **Site Map**

ASSOCIATED ENVIRONMENTAL INC.

- LEGEND:
- = Active UST Basin (1-10,000 g. gasoline & 1-10,000 g. diesel) & associated fueling system
 - = Monitor Well
 - = Plugged/Destroyed Well Location
 - = Site Property Boundary
 - = Site Benchmark

SCALE: **1" = 100'**

NOTES: