

PROJECT: FOR YOUR CONVENIENCE 1

ADDRESS: 1401 W. 11TH ST.

LOCATION: COFFEYVILLE, KS

DRAWN BY: B. SCOTT **DATE:** 04/08/2015

REVISED BY: C. ROE **DATE:** 05/10/2015


AEI JOB #: TF483 **KDHE JOB #:** U3-063-14719

TITLE:

Site Map

ASSOCIATED ENVIRONMENTAL INC.

- LEGEND:**
- = Active UST Basin (1-10,000 g. gasoline & 1-10,000 g. diesel) & associated fueling system
 - = Monitor Well
 - = Plugged/Destroyed Well Location
 - = Site Property Boundary
 - = Site Benchmark

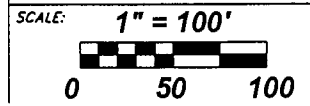

NOTES:

WATER WELL PLUGGING RECORD Form WWC-5P


KSA 82a-1212 ID NO.

MW8

1 LOCATION OF WATER WELL: County: <u>Montgomery</u>	Fraction <u>SW 1/4 SE 1/4 NE 1/4 NE 1/4</u>	Section Number <u>3</u>	Township Number <u>T 35 S</u>	Range Number <u>16</u> <input checked="" type="checkbox"/> E <input type="checkbox"/> W
---	--	----------------------------	----------------------------------	--

Street/Rural Address of Well Location; if unknown, distance & direction from nearest town or intersection: If at owner's address, check here <input type="checkbox"/> <u>1311 W. 11th St. Coffeyville, KS</u>	Global Positioning Systems (GPS) information: Latitude: <u>37.03309</u> (in decimal degrees) Longitude: <u>95.63883</u> (in decimal degrees) Elevation: <u>739.75</u> Horizontal Datum: <input type="checkbox"/> WGS84, <input checked="" type="checkbox"/> NAD83, <input type="checkbox"/> NAD27 Collection Method:
---	--

2 WATER WELL OWNER: Sunshine Fuel, LLC RR#, St. Address, Box #: <u>2751 SW Barnes Ave</u> City, State ZIP Code: <u>Independence, KS 67301</u>	<input type="checkbox"/> GPS unit (Make/Model: _____) <input type="checkbox"/> Digital Map/Photo, <input type="checkbox"/> Topographic Map, <input checked="" type="checkbox"/> Land Survey Est. Accuracy: <input checked="" type="checkbox"/> < 3 m, <input type="checkbox"/> 3-5 m, <input type="checkbox"/> 5-15 m, <input type="checkbox"/> > 15 m
---	--

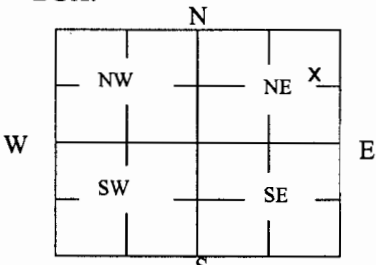3 MARK WELL'S LOCATION WITH AN "X" IN SECTION BOX: 	4 DEPTH OF WELL <u>15.04</u> ft. WELL'S STATIC WATER LEVEL <u>4.24</u> ft. WELL WAS USED AS: <input type="checkbox"/> Domestic <input type="checkbox"/> Public Water Supply <input type="checkbox"/> Dewatering <input type="checkbox"/> Irrigation <input type="checkbox"/> Oil Field Water Supply <input checked="" type="checkbox"/> Monitoring <input type="checkbox"/> Feedlot <input type="checkbox"/> Domestic (Lawn & Garden) <input type="checkbox"/> Injection Well <input type="checkbox"/> Industrial <input type="checkbox"/> Air Conditioning <input type="checkbox"/> Other _____ Was a chemical/bacteriological sample submitted to Department? Yes <input type="checkbox"/> No <input checked="" type="checkbox"/>
---	---

5 TYPE OF BLANK CASING USED:

Steel RMP (SR) Wrought Fiberglass Other (Specify below) _____
 PVC ABS Asbestos-Cement Concrete Tile _____

Blank casing diameter 2 in. Was casing pulled? Yes No If yes, how much 3 FT
 Casing height above or below land surface 36 in.

6 GROUT PLUG MATERIAL: Neat cement Cement grout Bentonite Other Soil

Grout Plug Intervals: From ¹ 15.04 ft. to 3.0 ft., From ² 3.0 ft. to 0.5 ft., From _____ ft. to _____ ft.

What is the nearest source of possible contamination:
 Septic tank Seepage pit Fuel storage Other (specify below) _____
 Sewer lines Pit privy Fertilizer storage _____
 Watertight sewer lines Sewage lagoon Insecticide storage _____
 Lateral lines Feedyard Abandoned water well Direction from well? S/SE
 Cess pool Livestock pens Oil well/Gas well How many feet? 120

FROM	TO	PLUGGING MATERIALS	FROM	TO	PLUGGING MATERIALS
3	0	Compact silt/clay soil			
15.04	3	Hydrated Bentonite Chips			

7 CONTRACTOR'S OR LANDOWNER'S CERTIFICATION: This water well was plugged under my jurisdiction and was completed on (mo/day/year) 3/28/17 and this record is true to the best of my knowledge and belief. Kansas Water Well Contractor's License No. 585. This Water Well Record was completed on (mo/day/year) 4/3/17 under the business name of Associated Environmental, Inc. by (signature) [Signature]