

# WATER WELL PLUGGING RECORD Form WWC-5P KSA 82a-1212 ID NO.

1 LOCATION OF WATER WELL: Fraction  $\frac{1}{4}$   $\frac{1}{4}$   $\frac{1}{4}$  NE  $\frac{1}{4}$  Section Number 3 Township Number T 35 S Range Number 22 ☒ E ☐ W

Street/Rural Address of Well Location; if unknown, distance & direction from nearest town or intersection: If at owner's address, check here ☐ 1599' South and 1005' West of the

intersection of SW 80th and 166 highway

## Global Positioning Systems (GPS) information:

Latitude: -94.980269 (in decimal degrees)

Longitude: 37.027474 (in decimal degrees)

Elevation: 874.30

Datum: ☐ WGS84, ☒ NAD83, ☐ NAD27


Collection Method:

☒ GPS unit (Make/Model: Crescent Hemisphere

☐ Digital Map/Photo, ☒ Topographic Map, ☐ Land Survey

Est. Accuracy: ☒ < 3 m, ☐ 3-5 m, ☐ 5-15 m, ☐ > 15 m

## 3 MARK WELL'S LOCATION WITH AN "X" IN SECTION BOX:

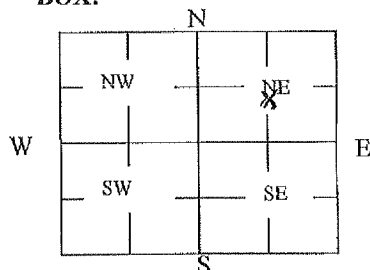

## 4 DEPTH OF WELL 27 ft.

WELL'S STATIC WATER LEVEL 16 ft

WELL WAS USED AS:

☒ Domestic  
☐ Irrigation  
☐ Feedlot  
☐ Industrial

☐ Public Water Supply  
☐ Oil Field Water Supply  
☐ Domestic (Lawn & Garden)  
☐ Air Conditioning

☐ Dewatering  
☐ Monitoring  
☐ Injection Well  
☐ Other

Was a chemical/bacteriological sample submitted to Department? Yes ☐ No ☒

## 5 TYPE OF BLANK CASING USED:

☐ Steel  
☐ PVC

☐ RMP (SR)  
☐ ABS

☐ Wrought  
☐ Asbestos-Cement

☐ Fiberglass  
☐ Concrete Tile

☒ Other (Specify below)  
Hand Laid Stone

Blank casing diameter 48" in. Was casing pulled? Yes ☐ No ☒ If yes, how much

Casing height above or below land surface 0 in.

## 6 GROUT PLUG MATERIAL: ☐ Neat cement ☒ Cement grout ☐ Bentonite ☐ Other

Grout Plug Intervals: From 4.5 ft. to 5.0 ft., From ft. to ft., From to ft.

What is the nearest source of possible contamination:

☐ Septic tank  
☐ Sewer lines  
☐ Watertight sewer lines  
☐ Lateral lines  
☐ Cess pool

☐ Seepage pit  
☐ Pit privy  
☐ Sewage lagoon  
☐ Feedyard  
☐ Livestock pens

☐ Fuel Storage  
☐ Fertilizer storage  
☐ Insecticide storage  
☐ Abandoned water well  
☐ Oil well/Gas well

☒ Other (specify below)  
N/A

Direction from well?   
How many feet?

FROM	TO	PLUGGING MATERIALS	FROM	TO	PLUGGING MATERIALS
27	11	clean aggregate < 1" diameter			
11	5	compacted clay soil			
5	4.5	cement plug			
4.5	0	top soil			

7 CONTRACTOR'S OR LANDOWNER'S CERTIFICATION: This water well was plugged under my jurisdiction and was completed on (mo/day/year) 9/19/2014 and this record is true to the best of my knowledge and belief. Kansas Water Well Contractor's License No. NA. This Water Well Record was completed on (mo/day/year) 9/19/2014 under the business name of Gale Bachman by (signature) Gale Bachman

INSTRUCTIONS: Use typewriter or ballpoint pen. Please press firmly and print clearly. Please fill in blanks, underline or circle the correct answers. Send one copy to Kansas Department of Health and Environment, Bureau of Water, Geology Section, 1000 SW Jackson St., Ste. 420, Topeka, Kansas 66612-1367. Telephone: 785/296-5524. Send one to Water Well Owner and retain one for your records. Visit us at <http://www.kdheks.gov/waterwell/index.html>.