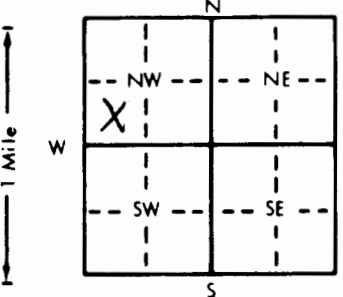


1 LOCATION OF WATER WELL:		Fraction	Section Number	Township Number	Range Number
County: Cherokee		1/4 SW 1/4 NW 1/4	9	T 35 S	R 25 E E/W
Distance and direction from nearest town or city street address of well if located within city? <i>2-2 of Baxter on 166-5 1/2 m</i>					
2 WATER WELL OWNER: John Tessman					
RR#, St. Address, Box #: Rt. 1, Box 237D					
City, State, ZIP Code: Baxter Sprrings, Kansas 66713					
Board of Agriculture, Division of Water Resources					
Application Number:					
3 LOCATE WELL'S LOCATION WITH AN "X" IN SECTION BOX:		4 DEPTH OF COMPLETED WELL: 343 ft. ELEVATION:			
		Depth(s) Groundwater Encountered 1. 310 ft. 2. ft. 3. ft.			
		WELL'S STATIC WATER LEVEL 125 ft. below land surface measured on mo/day/yr 2/4/97			
		Pump test data: Well water was ft. after hours pumping gpm			
		Est. Yield 20 gpm: Well water was ft. after hours pumping gpm			
		Bore Hole Diameter 8 5/8 in. to 6.3 ft. and 6 1/8 in. to 34.3 ft.			
		WELL WATER TO BE USED AS:			
		5 Public water supply 8 Air conditioning 11 Injection well			
		1 Domestic 3 Feedlot 6 Oil field water supply 9 Dewatering 12 Other (Specify below)			
		2 Irrigation 4 Industrial 7 Lawn and garden only 10 Monitoring well			
		Was a chemical/bacteriological sample submitted to Department? Yes No X; If yes, mo/day/yr sample was submitted			
		Water Well Disinfected? Yes X No			
5 TYPE OF BLANK CASING USED:					
1 Steel 3 RMP (SR) 5 Wrought iron 8 Concrete tile CASING JOINTS: Glued Clamped					
2 PVC 4 ABS 6 Asbestos-Cement 9 Other (specify below) Welded X					
Blank casing diameter 6 1/4 in. to 6.3 ft. Dia. in. to ft. Dia. in. to ft.					
Casing height above land surface 12 in. weight 13 lbs./ft. Wall thickness or gauge No.					
TYPE OF SCREEN OR PERFORATION MATERIAL:					
1 Steel 3 Stainless steel 5 Fiberglass 8 RMP (SR) 10 Asbestos-cement					
2 Brass 4 Galvanized steel 6 Concrete tile 9 ABS 11 Other (specify)					
12 None used (open hole)					
SCREEN OR PERFORATION OPENINGS ARE:					
1 Continuous slot 3 Mill slot 5 Gauzed wrapped 8 Saw cut 11 None (open hole)					
2 Louvered shutter 4 Key punched 6 Wire wrapped 9 Drilled holes					
7 Torch cut 10 Other (specify)					
SCREEN-PERFORATED INTERVALS: From ft. to ft. From ft. to ft. From ft. to ft.					
GRAVEL PACK INTERVALS: From ft. to ft. From ft. to ft. From ft. to ft.					
6 GROUT MATERIAL: 1 Neat cement 2 Cement grout 3 Bentonite 4 Other					
Grout Intervals: From 0 ft. to 6.3 ft. From ft. to ft. From ft. to ft.					
What is the nearest source of possible contamination:					
1 Septic tank 4 Lateral lines 7 Pit privy 10 Livestock pens 14 Abandoned water well					
2 Sewer lines 5 Cess pool 8 Sewage lagoon 11 Fuel storage 15 Oil well/Gas well					
3 Watertight sewer lines 6 Seepage pit 9 Feedyard 12 Fertilizer storage 16 Other (specify below)					
13 Insecticide storage					
Direction from well? North How many feet? 200					
FROM TO		LITHOLOGIC LOG		FROM TO PLUGGING INTERVALS	
0 20		Overburden			
20 305		Limestone			
305 310		Blue shale			
310 343		White flint & Sandy Limestone			
7 CONTRACTOR'S OR LANDOWNER'S CERTIFICATION: This water well was (1) constructed, (2) reconstructed, or (3) plugged under my jurisdiction and was completed on (mo/day/year) February 4, 1997 and this record is true to the best of my knowledge and belief. Kansas Water Well Contractor's License No. 321 This Water Well Record was completed on (mo/day/yr) 2/4/97 under the business name of Neosho Drilling Company by (signature) John Tessman					
INSTRUCTIONS: Use typewriter or ball point pen. PLEASE PRESS FIRMLY and PRINT clearly. Please fill in blanks, underline or circle the correct answers. Send top three copies to Kansas Department of Health and Environment, Bureau of Water, Topeka, Kansas 66620-0001. Telephone: 913-296-5545. Send one to WATER WELL OWNER and retain one for your records.					

OFFICE USE ONLY

T

R

EW

SEC.

1/4

1/4

1/4