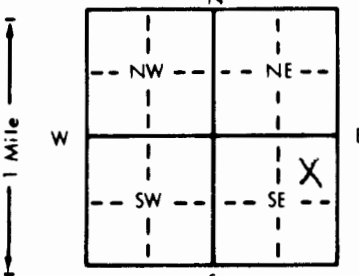


1 LOCATION OF WATER WELL: Fraction $\frac{1}{4}$ NE $\frac{1}{4}$ SE $\frac{1}{4}$ Section Number 4 Township Number T 35 S Range Number R 25E EW
 County: Cherokee
 Distance and direction from nearest town or city street address of well if located within city?

3-1/2 m E of Baxter Springs

2 WATER WELL OWNER: George R. Abbott
 RR#, St. Address, Box #: 519 E. 12th
 City, State, ZIP Code: Baxter Springs, Kansas 66713
 Board of Agriculture, Division of Water Resources
 Application Number:

3 LOCATE WELL'S LOCATION WITH AN "X" IN SECTION BOX:

 4 DEPTH OF COMPLETED WELL: 180 ft. ELEVATION:
 Depth(s) Groundwater Encountered 1. 160 ft. 2. ft. 3. ft.
 WELL'S STATIC WATER LEVEL: 60 ft. below land surface measured on mo/day/yr 10/15/97
 Pump test data: Well water was ft. after hours pumping gpm
 Est. Yield 25 gpm: Well water was ft. after hours pumping gpm
 Bore Hole Diameter: 8 5/8 in. to 6.3 in. and 6 1/8 in. to 180 in.
 WELL WATER TO BE USED AS:
 1 Domestic 3 Feedlot 6 Oil field water supply 9 Dewatering 12 Other (Specify below)
 2 Irrigation 4 Industrial 7 Lawn and garden only 10 Monitoring well
 Was a chemical/bacteriological sample submitted to Department? Yes No If yes, mo/day/yr sample was submitted
 Water Well Disinfected? Yes No

5 TYPE OF BLANK CASING USED:
 1 Steel 3 RMP (SR) 5 Wrought iron 8 Concrete tile CASING JOINTS: Glued Clamped
 2 PVC 4 ABS 6 Asbestos-Cement 9 Other (specify below) Welded
 7 Fiberglass Threaded
 Blank casing diameter 6 5/8 OD in. to 63 ft., Dia. in. to ft., Dia. in. to ft.
 Casing height above land surface 12 in., weight 13 lbs./ft. Wall thickness or gauge No.
 TYPE OF SCREEN OR PERFORATION MATERIAL:
 1 Steel 3 Stainless steel 5 Fiberglass 8 RMP (SR) 10 Asbestos-cement 11 Other (specify)
 2 Brass 4 Galvanized steel 6 Concrete tile 9 ABS 12 None used (open hole)
 SCREEN OR PERFORATION OPENINGS ARE:
 1 Continuous slot 3 Mill slot 5 Gauzed wrapped 8 Saw cut 11 None (open hole)
 2 Louvered shutter 4 Key punched 6 Wire wrapped 9 Drilled holes
 7 Torch cut 10 Other (specify)
 SCREEN-PERFORATED INTERVALS: From ft. to ft., From ft. to ft., From ft. to ft.
 GRAVEL PACK INTERVALS: From ft. to ft., From ft. to ft., From ft. to ft.

6 GROUT MATERIAL: ~~Neat cement~~ 2 Cement grout 3 Bentonite 4 Other
 Grout Intervals: From 0 ft. to 63 ft., From ft. to ft., From ft. to ft.
 What is the nearest source of possible contamination:
 1 Septic tank 4 Lateral lines 7 Pit privy 10 Livestock pens 14 Abandoned water well
 2 Sewer lines 5 Cess pool 8 Sewage lagoon 11 Fuel storage 15 Oil well/Gas well
 3 Watertight sewer lines 6 Seepage pit 9 Feedyard 12 Fertilizer storage 16 Other (specify below)
 13 Insecticide storage
 Direction from well? E How many feet? 200

FROM	TO	LITHOLOGIC LOG	FROM	TO	PLUGGING INTERVALS
0	30	Overburden			
30	140	Limestone			
140	180	Blue & white flint			

7 CONTRACTOR'S OR LANDOWNER'S CERTIFICATION: This water well was (1) constructed, (2) reconstructed, or (3) plugged under my jurisdiction and was completed on (mo/day/year) October 15, 1997 and this record is true to the best of my knowledge and belief. Kansas Water Well Contractor's License No. 321 This Water Well Record was completed on (mo/day/yr) 10/15/97 under the business name of Neosho Drilling Company by (signature)