

County: Cherokee Fraction NE NE NW SE Sec. 12 T 35 S R 25 (E/W)

CORRECTION(S) TO WATER WELL COMPLETION RECORD (WWC-5)  
(to rectify lacking or incorrect information)

Owner: Hai-Ching Ying

Location was listed as:

Section-Township-Range: 12-35S-25E

Fraction ( $\frac{1}{4}$   $\frac{1}{4}$   $\frac{1}{4}$ ): SE SE SE

Location changed to:

12-35S-25E

NE NE NW SE

Other changes: Initial statements: Other

Changed to: Domestic


Comments:

Verification method: Legal description, Cherokee County online parcel search, and mapping tool & aerial photos on KGS website.

Submitted by: Kansas Geological Survey, Data Resources Library, 1930 Constant Ave., Lawrence, KS 66047-3726  
to: Kansas Dept of Health & Environment, Bureau of Water, 1000 SW Jackson, Suite 420, Topeka, KS 66612-1367.

initials: DRL date: 4/26/2013



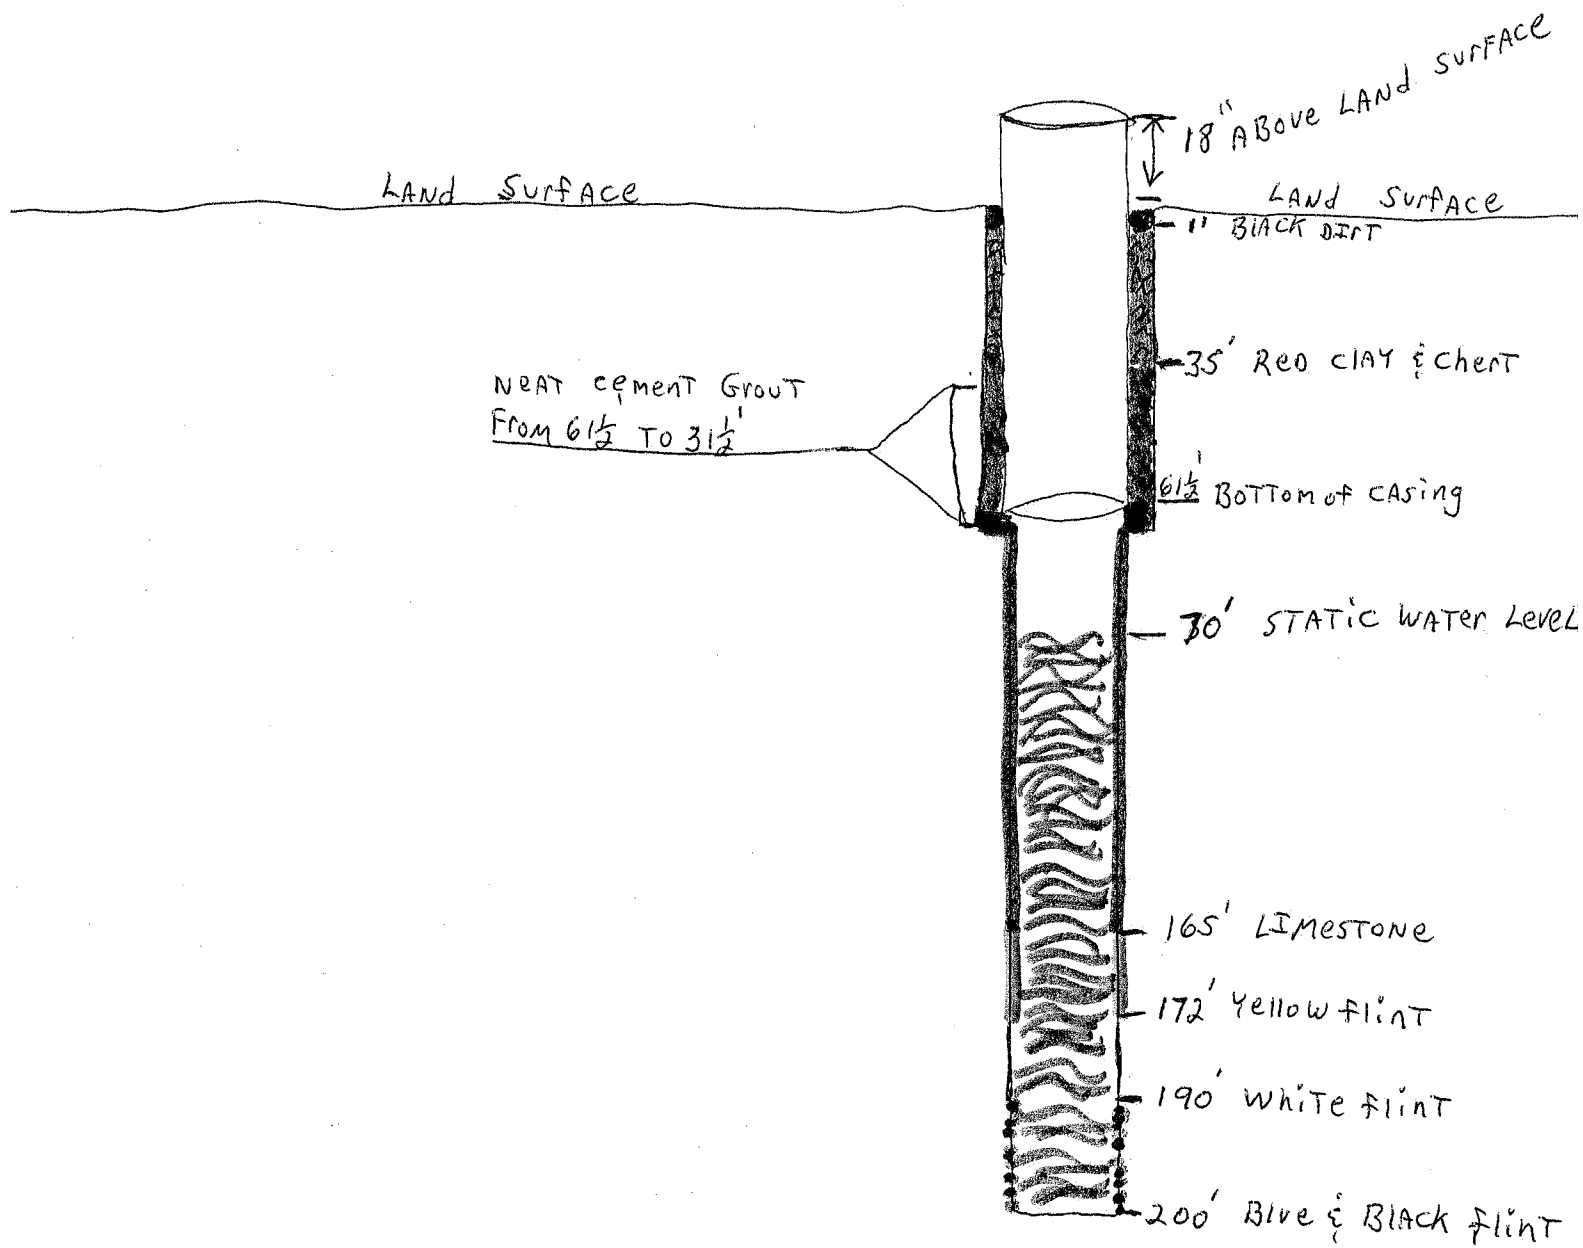

RECEIVED

NOV 17 2003

BUREAU OF WATER