


1 LOCATION OF WATER WELL: County: Cherokee Fraction: NW 1/4 NW 1/4 NW 1/4 Section Number: 9 Township Number: T 35 S Range Number: R 25 EW

Distance and direction from nearest town or city street address of well if located within city?

2 WATER WELL OWNER: Matt Hulsey
 RR#, St. Address, Box #: 9028 SE STAR RD Board of Agriculture, Division of Water Resources
 City, State, ZIP Code: Baxter Springs, KS 66713 Application Number:

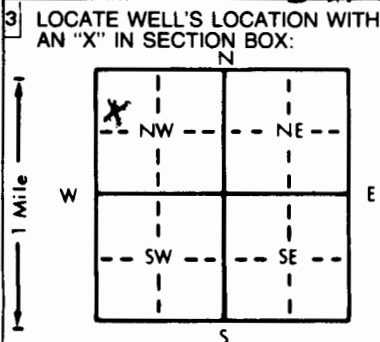

4 DEPTH OF COMPLETED WELL: 307' ft. ELEVATION:
 Depth(s) Groundwater Encountered 1. 290 ft. 2. 290 ft. 3. 290 ft.
 WELL'S STATIC WATER LEVEL: 127 ft. below land surface measured on mo/day/yr 8-29-04
 Pump test data: Well water was _____ ft. after _____ hours pumping _____ gpm
 Est. Yield: 3.0 gpm; Well water was _____ ft. after _____ hours pumping _____ gpm
 Bore Hole Diameter: 9 in. to 41 ft., and 6 1/8 in. to 307 ft.
 WELL WATER TO BE USED AS:
 Domestic 3 Feedlot 6 Oil field water supply 9 Dewatering 12 Other (Specify below)
 2 Irrigation 4 Industrial 7 Lawn and garden only 10 Monitoring well
 Was a chemical/bacteriological sample submitted to Department? Yes _____ No _____; If yes, mo/day/yr sample was submitted _____
 Water Well Disinfected? Yes No

5 TYPE OF BLANK CASING USED:
 1 Steel 3 RMP (SR) 5 Wrought iron 8 Concrete tile CASING JOINTS: Glued _____ Clamped _____
 2 PVC 4 ABS 6 Asbestos-Cement 9 Other (specify below) Welded
 7 Fiberglass _____ Threaded _____
 Blank casing diameter: 6 1/8 in. to 42 ft. Dia _____ in. to _____ ft. Dia _____ in. to _____ ft.
 Casing height above land surface: 1 in., weight 134 lbs./ft. Wall thickness or gauge No. 188

TYPE OF SCREEN OR PERFORATION MATERIAL:
 1 Steel 3 Stainless steel 5 Fiberglass 7 PVC 10 Asbestos-cement
 2 Brass 4 Galvanized steel 6 Concrete tile 9 ABS 11 Other (specify) _____
 12 None used (open hole)
 SCREEN OR PERFORATION OPENINGS ARE:
 1 Continuous slot 3 Mill slot 5 Gauzed wrapped 8 Saw cut 11 None (open hole)
 2 Louvered shutter 4 Key punched 7 Torch cut 9 Drilled holes
 SCREEN-PERFORATED INTERVALS: From _____ ft. to _____ ft., From _____ ft. to _____ ft.
 GRAVEL PACK INTERVALS: From _____ ft. to _____ ft., From _____ ft. to _____ ft.

6 GROUT MATERIAL: 1 Neat cement 2 Cement grout 3 Bentonite 4 Other _____
 Grout Intervals: From 41 ft. to 11 ft., From _____ ft. to _____ ft., From _____ ft. to _____ ft.
 What is the nearest source of possible contamination:
 Septic tank 4 Lateral lines 7 Pit privy 10 Livestock pens 14 Abandoned water well
 2 Sewer lines 5 Cess pool 8 Sewage lagoon 11 Fuel storage 15 Oil well/Gas well
 3 Watertight sewer lines 6 Seepage pit 9 Feedyard 12 Fertilizer storage 16 Other (specify below)
 Direction from well? SOUTH How many feet? 150'

FROM	TO	LITHOLOGIC LOG	FROM	TO	PLUGGING INTERVALS
0	16	OVERBURDEN			
16	148	Grey Lime			
148	252	Chert			
252	307	Grey Lime			

RECEIVED
 SEP 01 2004
 BUREAU OF WATER

7 CONTRACTOR'S OR LANDOWNER'S CERTIFICATION: This water well was (1) constructed, (2) reconstructed, or (3) plugged under my jurisdiction and was completed on (mo/day/year) 8-29-04 and this record is true to the best of my knowledge and belief. Kansas Water Well Contractor's License No. 492 This Water Well Record was completed on (mo/day/yr) _____ under the business name of TICHNOR DRILLING INC by (signature) Jean Tichnor