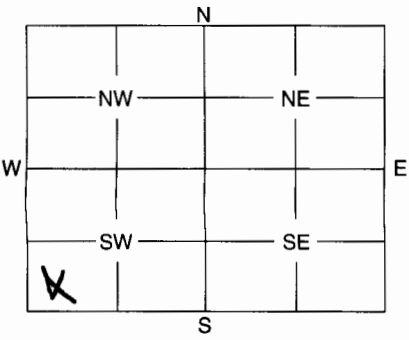


1	LOCATION OF WATER WELL: County: CHEROKEE	Fraction ¼ SW ¼ SW ¼	Section Number 13	Township Number T35S	Range Number R25
---	--	--------------------------------	-----------------------------	--------------------------------	----------------------------

Distance and direction from nearest town or city street address of well if located within city?
From Baxter Springs, turn East on Hwy 400/100 Approx 8 mi to site

2	WATER WELL OWNER: DOWNSTREAM CASINO AUTHORITY RR #, St. Address, Box #: 125 W THROST City, State, ZIP Code: TULSA, OK 74103	Board of Agriculture, Division of Water Resources Application Number:
---	--	--

3	MARK WELL'S LOCATION WITH AN "X" IN SECTION BOX: 	4	DEPTH OF WELL 200 ft. WELL'S STATIC WATER LEVEL 67 ft. WELL WAS USED AS: <input checked="" type="checkbox"/> 1 Domestic <input type="checkbox"/> 2 Irrigation <input type="checkbox"/> 3 Feedlot <input type="checkbox"/> 4 Industrial <input type="checkbox"/> 5 Public Water Supply <input type="checkbox"/> 6 Oil Field Water Supply <input type="checkbox"/> 7 Domestic (Lawn & Garden) <input type="checkbox"/> 8 Air Conditioning <input type="checkbox"/> 9 Dewatering <input type="checkbox"/> 10 Monitoring Well <input type="checkbox"/> 11 Injection Well <input type="checkbox"/> 12 Other Was a chemical / bacteriological sample submitted to Department? Yes No <input checked="" type="checkbox"/> If yes, mo/day/yr sample was submitted Water Well Disinfected: Yes No <input checked="" type="checkbox"/>
---	--	---	---

5	TYPE OF BLANK CASING USED: <input checked="" type="checkbox"/> 1 Steel <input type="checkbox"/> 2 PVC <input type="checkbox"/> 3 RMP (SR) <input type="checkbox"/> 4 ABS <input type="checkbox"/> 5 Wrought <input type="checkbox"/> 6 Asbestos-Cement <input type="checkbox"/> 7 Fiberglass <input type="checkbox"/> 8 Concrete Tile <input type="checkbox"/> 9 Other (Specify below) Blank casing diameter 6.875 in. Was casing pulled? Yes No <input checked="" type="checkbox"/> Casing height above or below land surface 36 in. If yes, how much
---	---

6	GROUT PLUG MATERIAL: <input checked="" type="checkbox"/> 1 Neat cement <input type="checkbox"/> 2 Cement grout <input type="checkbox"/> 3 Bentonite <input type="checkbox"/> 4 Other Grout Plug Intervals: From 200 ft. to 3 ft., From ft. to ft., From to ft. What is the nearest source of possible contamination: <input checked="" type="checkbox"/> 1 Septic tank <input type="checkbox"/> 2 Sewer lines <input type="checkbox"/> 3 Watertight sewer lines <input type="checkbox"/> 4 Lateral lines <input type="checkbox"/> 5 Cess pool <input type="checkbox"/> 6 Seepage pit <input type="checkbox"/> 7 Pit privy <input type="checkbox"/> 8 Sewage lagoon <input type="checkbox"/> 9 Feedyard <input type="checkbox"/> 10 Livestock pens <input type="checkbox"/> 11 Fuel storage <input type="checkbox"/> 12 Fertilizer storage <input type="checkbox"/> 13 Insecticide storage <input type="checkbox"/> 14 Abandoned water well <input type="checkbox"/> 15 Oil well/Gas well <input type="checkbox"/> 16 Other (specify below) Direction from well? SW How many feet? 450
---	---

FROM	TO	PLUGGING MATERIALS
200'	3.0'	NEAT CEMENT (1 Bag PORTLAND / 6 gallon H ₂ O)

7	CONTRACTOR'S OR LANDOWNER'S CERTIFICATION: This water well was plugged under my jurisdiction and was completed on (mo/day/year) 02/19/08 and this record is true to the best of my knowledge and belief. Kansas Water Well Contractor's License No. 754 This Water Well Record was completed on (mo/day/year) 02/22/08 under the business name of PALMERTON & PARRISH, INC by (signature) Brad R. Parrish
---	---

INSTRUCTIONS: Use typewriter or ball point pen. Please press firmly and print clearly. Please fill in blanks, underline or circle the correct answers. Send top three copies to Kansas Department of Health and Environment, Bureau of Water, Geology Section, 1000 SW Jackson St., Ste. 420, Topeka, Kansas 66612-1367. Telephone: 785/296-5522. Send one to Water Well Owner and retain one for your records.