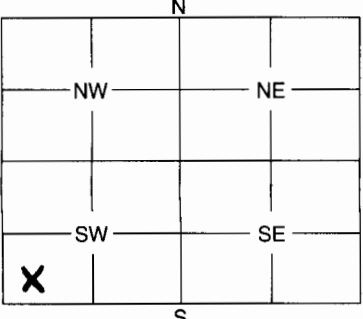


1	LOCATION OF WATER WELL: County: CHEROKEE	Fraction 1/4 SW 1/4 SW 1/4	Section Number 13	Township Number T35S	Range Number R25	EW
---	--	--------------------------------------	-----------------------------	--------------------------------	----------------------------	-----------

Distance and direction from nearest town or city street address of well if located within city?
FROM BAXTER SPRINGS, TURN EAST ON HWY 400/166 APPROX 8 MI TO SITE.

2	WATER WELL OWNER: DOWNSTREAM CASINO AUTHORITY RR #, St. Address, Box #: 125 W THIRD ST City, State, ZIP Code: TULSA, OK 74103	Board of Agriculture, Division of Water Resources Application Number:
---	--	--

3	MARK WELL'S LOCATION WITH AN "X" IN SECTION BOX: 	4	DEPTH OF WELL 200 ft. WELL'S STATIC WATER LEVEL 65 ft. WELL WAS USED AS: <input checked="" type="checkbox"/> Domestic 2 Irrigation 3 Feedlot 4 Industrial 5 Public Water Supply 6 Oil Field Water Supply 7 Domestic (Lawn & Garden) 8 Air Conditioning 9 Dewatering 10 Monitoring Well 11 Injection Well 12 Other Was a chemical / bacteriological sample submitted to Department? Yes No <input checked="" type="checkbox"/> If yes, mo/day/yr sample was submitted Water Well Disinfected: Yes No <input checked="" type="checkbox"/>
---	--	---	--

5	TYPE OF BLANK CASING USED: <input checked="" type="checkbox"/> Steel 2 PVC 3 RMP (SR) 4 ABS 5 Wrought 6 Asbestos-Cement 7 Fiberglass 8 Concrete Tile 9 Other (Specify below)	Blank casing diameter 6.625 in. Casing height above or below land surface 310 in.	Was casing pulled? Yes No <input checked="" type="checkbox"/> If yes, how much
---	---	--	---

6	GROUT PLUG MATERIAL: <input checked="" type="checkbox"/> Neat cement 2 Cement grout 3 Bentonite 4 Other	Grout Plug Intervals: From 200 ft. to 3.0 ft., From ft. to ft., From to ft.	What is the nearest source of possible contamination: <input checked="" type="checkbox"/> Septic tank 2 Sewer lines 3 Watertight sewer lines 4 Lateral lines 5 Cess pool 6 Seepage pit 7 Pit privy 8 Sewage lagoon 9 Feedyard 10 Livestock pens 11 Fuel storage 12 Fertilizer storage 13 Insecticide storage 14 Abandoned water well 15 Oil well/Gas well 16 Other (specify below)
Direction from well? SW		How many feet? 150	

FROM	TO	PLUGGING MATERIALS
200'	3'	NEAT CEMENT (1 Bag PORTLAND / 6 gallon H ₂ O)

7	CONTRACTOR'S OF LANDOWNER'S CERTIFICATION: This water well was plugged under my jurisdiction and was completed on (mo/day/year) 02/19/08 and this record is true to the best of my knowledge and belief. Kansas Water Well Contractor's License No. 754 This Water Well Record was completed on (mo/day/year) 02/22/08 under the business name of PALMER & PARRISH, INC by (signature) Priscilla E. James
---	--

INSTRUCTIONS: Use typewriter or ball point pen. Please press firmly and print clearly. Please fill in blanks, underline or circle the correct answers. Send top three copies to Kansas Department of Health and Environment, Bureau of Water, Geology Section, 1000 SW Jackson St., Ste. 420, Topeka, Kansas 66612-1367. Telephone: 785/296-5522. Send one to Water Well Owner and retain one for your records.