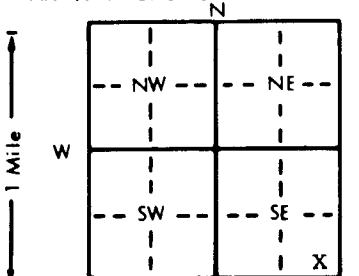


1 LOCATION OF WATER WELL: Fraction SE 1/4 SE 1/4 SE 1/4 Section Number 11 Township Number T 35 S Range Number R 25E E/W  
 County: Cherokee

Distance and direction from nearest town or city street address of well if located within city?  
*5.5 miles E of Board Springs 1 1/2 South*

2 WATER WELL OWNER: Roger Howell  
 RR#, St. Address, Box #: Rt. 2, Box 457 Board of Agriculture, Division of Water Resources  
 City, State, ZIP Code: Galena, Kansas 66739 Application Number:

3 LOCATE WELL'S LOCATION WITH AN "X" IN SECTION BOX:  


4 DEPTH OF COMPLETED WELL: 200 ft. ELEVATION:  
 Depth(s) Groundwater Encountered 1. 180 ft. 2. ft. 3. ft.  
 WELL'S STATIC WATER LEVEL: 60 ft. below land surface measured on mo/day/yr 6/25/92  
 Pump test data: Well water was ft. after hours pumping gpm  
 Est. Yield 25 gpm: Well water was ft. after hours pumping gpm  
 Bore Hole Diameter 8 5/8 in. to 6.3 ft. and 6 1/8 in. to 2.00 ft.  
 WELL WATER TO BE USED AS:  
 5 Public water supply 8 Air conditioning 11 Injection well  
 1 Domestic 3 Feedlot 6 Oil field water supply 9 Dewatering 12 Other (Specify below)  
 2 Irrigation 4 Industrial 7 Lawn and garden only 10 Monitoring well  
 Was a chemical/bacteriological sample submitted to Department? Yes No  If yes, mo/day/yr sample was submitted  
 Water Well Disinfected? Yes  No

5 TYPE OF BLANK CASING USED:  
 1 Steel 3 RMP (SR) 5 Wrought iron 8 Concrete tile CASING JOINTS: Glued Clamped  
 2 PVC 4 ABS 6 Asbestos-Cement 9 Other (specify below) Welded   
 7 Fiberglass Threaded  
 Blank casing diameter 6 1/4 in. to 6.3 ft. Dia. in. to ft. Dia. in. to ft.  
 Casing height above land surface 12 in., weight 13 lbs./ft. Wall thickness or gauge No.  
 TYPE OF SCREEN OR PERFORATION MATERIAL:  
 1 Steel 3 Stainless steel 5 Fiberglass 8 RMP (SR) 10 Asbestos-cement  
 2 Brass 4 Galvanized steel 6 Concrete tile 9 ABS 11 Other (specify)  
 12 None used (open hole)  
 SCREEN OR PERFORATION OPENINGS ARE:  
 1 Continuous slot 3 Mill slot 5 Gauzed wrapped 8 Saw cut 11 None (open hole)  
 2 Louvered shutter 4 Key punched 6 Wire wrapped 9 Drilled holes  
 7 Torch cut 10 Other (specify)  
 SCREEN-PERFORATED INTERVALS: From ft. to ft. From ft. to ft.  
 GRAVEL PACK INTERVALS: From ft. to ft. From ft. to ft.

6 GROUT MATERIAL: # Neat cement 2 Cement grout 3 Bentonite 4 Other  
 Grout Intervals: From 0 ft. to 6.3 ft. From ft. to ft. From ft. to ft.  
 What is the nearest source of possible contamination:  
 1 Septic tank 4 Lateral lines 7 Pit privy 10 Livestock pens 14 Abandoned water well  
 2 Sewer lines 5 Cess pool 8 Sewage lagoon 11 Fuel storage 15 Oil well/Gas well  
 3 Watertight sewer lines 6 Seepage pit 9 Feedyard 12 Fertilizer storage 16 Other (specify below)  
 13 Insecticide storage  
 Direction from well? How many feet?

FROM	TO	LITHOLOGIC LOG	FROM	TO	PLUGGING INTERVALS
0	20	Overburden			
20	40	Flint			
40	160	Limestone			
160	180	Coarse blue & white flint			
180	200	Limestone & flint			

7 CONTRACTOR'S OR LANDOWNER'S CERTIFICATION: This water well was (1) constructed, (2) reconstructed, or (3) plugged under my jurisdiction and was completed on (mo/day/year) 6/25/92 and this record is true to the best of my knowledge and belief. Kansas  
 Water Well Contractor's License No. 321 This Water Well Record was completed on (mo/day/yr) 7/16/92  
 under the business name of Neosho Drilling Company by (signature) John Hill

OFFICE USE ONLY

T

R

EW

SEC.

1/4

1/4

1/4