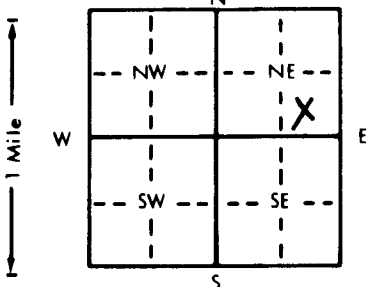


1 LOCATION OF WATER WELL:		Fraction	Section Number	Township Number	Range Number
County: Cherokee		$NC \frac{1}{4} SE \frac{1}{4} NE \frac{1}{4}$	2	T 35 S	R 25E EW
Distance and direction from nearest town or city street address of well if located within city? <u>5 1/2 mi E of Baxter Springs KS</u>					
2 WATER WELL OWNER: Mark Sell					
RR#, St. Address, Box #: Rt. 1, Box 274					
City, State, ZIP Code: Baxter Springs, Kansas 66713					
Board of Agriculture, Division of Water Resources					
Application Number:					
3 LOCATE WELL'S LOCATION WITH AN "X" IN SECTION BOX:		4 DEPTH OF COMPLETED WELL: 140 ft. ELEVATION:			
		Depth(s) Groundwater Encountered 1. 130-140 ft. 2. ft. 3. ft.			
		WELL'S STATIC WATER LEVEL: 50 ft. below land surface measured on mo/day/yr 7/5/94			
		Pump test data: Well water was ft. after hours pumping gpm			
		Est. Yield: 20 gpm Well water was ft. after hours pumping gpm			
		Bore Hole Diameter: 8 5/8 in. to 10 1/2 in. and 6 1/8 in. to 140 in.			
		WELL WATER TO BE USED AS:			
		5 Public water supply 8 Air conditioning 11 Injection well			
		1 Domestic 3 Feedlot 6 Oil field water supply 9 Dewatering 12 Other (Specify below)			
		2 Irrigation 4 Industrial 7 Lawn and garden only 10 Monitoring well			
		Was a chemical/bacteriological sample submitted to Department? Yes No X If yes, mo/day/yr sample was submitted			
		Water Well Disinfected? Yes X No			
5 TYPE OF BLANK CASING USED:					
1 Steel 3 RMP (SR) 5 Wrought iron 8 Concrete tile CASING JOINTS: Glued Clamped					
2 PVC 4 ABS 6 Asbestos-Cement 9 Other (specify below) Welded X					
7 Fiberglass Threaded					
Blank casing diameter: 6 1/4 in. to 10 1/2 in. Dia. in. to ft. Dia. in. to ft.					
Casing height above land surface: 12 in., weight 13 lbs./ft. Wall thickness or gauge No.					
TYPE OF SCREEN OR PERFORATION MATERIAL:					
1 Steel 3 Stainless steel 5 Fiberglass 8 RMP (SR) 10 Asbestos-cement					
2 Brass 4 Galvanized steel 6 Concrete tile 9 ABS 11 Other (specify)					
X 2 None used (open hole)					
SCREEN OR PERFORATION OPENINGS ARE:					
1 Continuous slot 3 Mill slot 5 Gauzed wrapped 8 Saw cut 11 None (open hole)					
2 Louvered shutter 4 Key punched 6 Wire wrapped 9 Drilled holes					
7 Torch cut 10 Other (specify)					
SCREEN-PERFORATED INTERVALS: From ft. to ft. From ft. to ft. From ft. to ft.					
GRAVEL PACK INTERVALS: From ft. to ft. From ft. to ft. From ft. to ft.					
6 GROUT MATERIAL: 1 Neat cement 2 Cement grout 3 Bentonite 4 Other					
Grout Intervals: From 0 ft. to 30 ft. From ft. to ft. From ft. to ft.					
What is the nearest source of possible contamination:					
1 Septic tank 4 Lateral lines 7 Pit privy 10 Livestock pens 14 Abandoned water well					
2 Sewer lines 5 Cess pool 8 Sewage lagoon 11 Fuel storage 15 Oil well/Gas well					
3 Watertight sewer lines 6 Seepage pit 9 Feedyard 12 Fertilizer storage 16 Other (specify below)					
13 Insecticide storage					
Direction from well? Southeast How many feet? 100					
FROM	TO	LITHOLOGIC LOG	FROM	TO	PLUGGING INTERVALS
0	80	Overburden			
80	130	Limestone			
130	140	Broken flint			
7 CONTRACTOR'S OR LANDOWNER'S CERTIFICATION: This water well was (1) constructed, (2) reconstructed, or (3) plugged under my jurisdiction and was completed on (mo/day/year) July 5, 1994 and this record is true to the best of my knowledge and belief. Kansas					
Water Well Contractor's License No. 321 This Water Well Record was completed on (mo/day/yr) July 22, 1994					
under the business name of Neosho Drilling Company by (signature) John Miller					
INSTRUCTIONS: Use typewriter or ball point pen. PLEASE PRESS FIRMLY and PRINT clearly. Please fill in blanks, underline or circle the correct answers. Send top three copies to Kansas Department of Health and Environment, Bureau of Water, Topeka, Kansas 66620-0001. Telephone: 913-296-5545. Send one to WATER WELL OWNER and retain one for your records.					