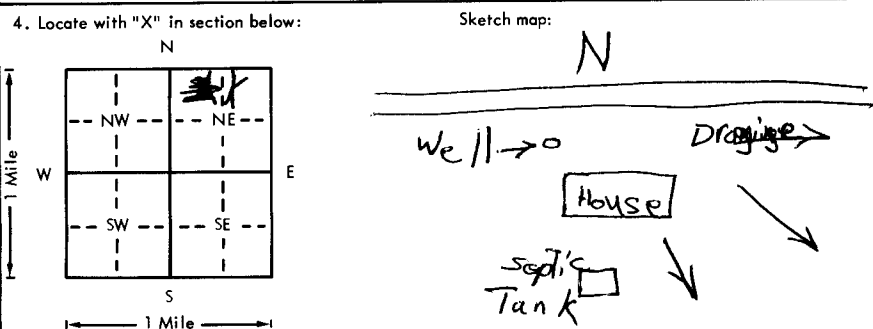


USE TYPEWRITER OR BALL POINT PEN-PRESS FIRMLY, PRINT CLEARLY.

WATER WELL RECORD  
KSA 82a-1201-1215

Kansas Department of Health and Environment-Division of Environment  
(Water well Contractors)  
Topeka, Kansas 66620

1. Location of well: County <b>Cowley</b> Fraction <b>NE 1/4 NE 1/4 NE 1/4</b> Section number <b>3</b> Township number <b>T 35 0</b> Range number <b>R 3</b> <span style="float:right">E/W</span>	
2. Distance and direction from nearest town or city: <b>2 miles SW of ARKANSAS CITY</b> 3. Owner of well: <b>BILL RUSSELL</b> R.R. or street: <b>RT 4</b> City, state, zip code: <b>Arkansas City, Kans 67005</b>	
4. Locate with "X" in section below: Sketch map: 	
5. Type and color of material	
	From To
<b>Top Soil</b>	0' 3"
<b>Red clay</b>	3' 35'
<b>Grey Schale</b>	35' 55'
<b>Cream-colored Limestone</b>	55' 60'
<b>HARD BLUE SchALE</b>	60' 65'
(Use a second sheet if needed)	
18. Elevation: Topography: <input checked="" type="checkbox"/> Hill <input type="checkbox"/> Slope <input type="checkbox"/> Upland <input type="checkbox"/> Valley	19. Remarks: <b>Pump and well head to be completed by landowner.</b>
6. Bore hole dia. <b>10</b> in. Completion date <b>7-21-78</b> Well depth <b>65</b> ft.	
7. <input checked="" type="checkbox"/> Cable tool <input checked="" type="checkbox"/> Rotary <input type="checkbox"/> Driven <input type="checkbox"/> Dug <input type="checkbox"/> Hollow rod <input type="checkbox"/> Jetted <input type="checkbox"/> Bored <input type="checkbox"/> Reverse rotary	
8. Use: <input checked="" type="checkbox"/> Domestic <input type="checkbox"/> Public supply <input type="checkbox"/> Industry <input type="checkbox"/> Irrigation <input type="checkbox"/> Air conditioning <input type="checkbox"/> Stock <input type="checkbox"/> Lawn <input type="checkbox"/> Oil field water <input type="checkbox"/> Other	
9. Casing: Material <b>RMP</b> Height <b>Above</b> or below Threading <input type="checkbox"/> Welded <input type="checkbox"/> Surface <b>1 1/2</b> in. RMP <input checked="" type="checkbox"/> PVC <input type="checkbox"/> Weight <b>155/100</b> lbs./ft. Dia. <b>60</b> in. to <b>65</b> ft. depth Wall Thickness: inches or Dia. <input type="checkbox"/> in. to <input type="checkbox"/> ft. depth gage No. <b>1/8</b>	
10. Screen: Manufacturer's name <b>Sunflower</b> Type <b>RMP</b> Dia. <b>6"</b> Slot/gauze <b>1/16</b> Length <b>20'</b> Set between <b>45</b> ft. and <b>65</b> ft. ft. and <input type="checkbox"/> ft. Gravel pack? <input checked="" type="checkbox"/> Yes Size range of material <b>1/4"</b>	
11. Static water level: <input type="checkbox"/> mo./day/yr. <b>38</b> ft. below land surface Date <b>7-21-78</b>	
12. Pumping level below land surfaces: <b>48</b> ft. after <b>1</b> hrs. pumping <b>12</b> g.p.m. <input type="checkbox"/> ft. after <input type="checkbox"/> hrs. pumping <input type="checkbox"/> g.p.m. Estimated maximum yield <b>NA</b> g.p.m.	
13. Water sample submitted: <input type="checkbox"/> Yes <input checked="" type="checkbox"/> No Date <input type="checkbox"/>	
14. Well head completion: <b>NO</b> <input type="checkbox"/> Pitless adapter <input type="checkbox"/> Inches above grade	
15. Well grouted? <b>Yes</b> With: <input checked="" type="checkbox"/> Negt cement <input type="checkbox"/> Bentonite <input type="checkbox"/> Concrete Depth: From <b>0</b> ft. to <b>13</b> ft.	
16. Nearest source of possible contamination: ft. <b>100</b> Direction <b>South</b> Type <b>Septic Tank</b> Well disinfected upon completion? <input checked="" type="checkbox"/> Yes <input type="checkbox"/> No	
17. Pump: <input checked="" type="checkbox"/> Not installed Manufacturer's name <input type="checkbox"/> Model number <input type="checkbox"/> HP <input type="checkbox"/> Volts <input type="checkbox"/> Length of drop pipe <input type="checkbox"/> ft. capacity <input type="checkbox"/> g.p.m. Type: <input type="checkbox"/> Submersible <input type="checkbox"/> Turbine <input type="checkbox"/> Jet <input type="checkbox"/> Reciprocating <input type="checkbox"/> Centrifugal <input type="checkbox"/> Other	
20. Water well contractor's certification: This well was drilled under my jurisdiction and this report is true to the best of my knowledge and belief. <b>EASTMAN Drilling 297</b> License No. <input type="checkbox"/> Business name <b>Box 115, Winfield,</b> Address <b>Dale Eastman</b> Signed <b>Dale Eastman</b> Date <b>7-21-78</b> Authorized representative	

35 T 35 0 R 3 NE 1/4 NE 1/4 NE 1/4

Forward the white, blue and pink copies to the Department of Health and Environment

Farm WWC-5