


1 LOCATION OF WATER WELL: County: Cowley Fraction SE SE Section Number 5 Township Number T 35 S Range Number 4 E EW
 Distance and direction from nearest town or city street address of well if located within city? 2 mile East of 1 1/2 mile South of Arkansas City Ks

2 WATER WELL OWNER: Bob Meadows Board of Agriculture, Division of Water Resources
 RR#, St. Address, Box #: PO Box 661 Application Number:
 City, State, ZIP Code: Arkansas City Kansas 67005

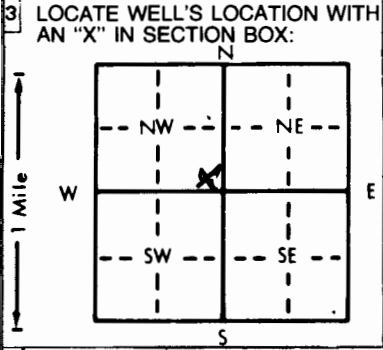

4 DEPTH OF COMPLETED WELL: 27' 6" ft. ELEVATION:
 Depth(s) Groundwater Encountered 1. 14' ft. 2. ft. 3. ft.
 WELL'S STATIC WATER LEVEL ft. below land surface measured on mo/day/yr
 Pump test data: Well water was 14' ft. after 3 hours pumping 5 gpm
 Est. Yield 10 gpm Well water was ft. after hours pumping gpm
 Bore Hole Diameter 8" in. to 27' 6" ft., and in. to ft.
 WELL WATER TO BE USED AS: 5 Public water supply 8 Air conditioning 11 Injection well
 1 Domestic 3 Feedlot 6 Oil field water supply 9 Dewatering 12 Other (Specify below)
 2 Irrigation 4 Industrial 7 Lawn and garden only 10 Observation well
 Was a chemical/bacteriological sample submitted to Department? Yes No X If yes, mo/day/yr sample was submitted Water Well Disinfected? Yes X No

5 TYPE OF BLANK CASING USED: 5 Wrought iron 8 Concrete tile CASING JOINTS Glued Clamped
 1 Steel 3 RMP (SR) 6 Asbestos-Cement 9 Other (specify below) Welded
PVC 4 ABS 7 Fiberglass Threaded
 Blank casing diameter 8" in. to 22" ft. Dia. in. to ft. Dia. in. to ft.
 Casing height above land surface 12" in. weight Sch 40 lbs./ft. Wall thickness or gauge No. Sch 40
 TYPE OF SCREEN OR PERFORATION MATERIAL: PVC 10 Asbestos-cement
 1 Steel 3 Stainless steel 5 Fiberglass 8 RMP (SR) 11 Other (specify)
 2 Brass 4 Galvanized steel 6 Concrete tile 9 ABS 12 None used (open hole)
 SCREEN OR PERFORATION OPENINGS ARE: 5 Gauzed wrapped Saw cut 11 None (open hole)
 1 Continuous slot 3 Mill slot 6 Wire wrapped 9 Drilled holes
 2 Louvered shutter 4 Key punched 7 Torch cut 10 Other (specify)
 SCREEN-PERFORATED INTERVALS: From 22' ft. to 27' 6" ft. From ft. to ft.
 From 17' ft. to 27' 6" ft. From ft. to ft.
 GRAVEL PACK INTERVALS: From ft. to ft. From ft. to ft.

6 GROUT MATERIAL: 1 Neat cement Cement grout 3 Bentonite 4 Other
 Grout Intervals: From 1' ft. to 15' ft. From ft. to ft. From ft. to ft.
 What is the nearest source of possible contamination:
 1 Septic tank 4 Lateral lines 7 Pit privy 10 Livestock pens 14 Abandoned water well
 2 Sewer lines 5 Cess pool 8 Sewage lagoon 11 Fuel storage 15 Oil well/Gas well
 3 Watertight sewer lines 6 Seepage pit 9 Feedyard 12 Fertilizer storage 16 Other (specify below)
 13 Insecticide storage
 Direction from well? How many feet? None

FROM	TO	LITHOLOGIC LOG	FROM	TO	LITHOLOGIC LOG
1	10	06 Very Fine Sand			
11	24	08 Medium Sand			
25	29	09 Coarse Sand			
		Set casing to 27' 6"			

7 CONTRACTOR'S OR LANDOWNER'S CERTIFICATION: This water well was (1) constructed, (2) reconstructed, or (3) plugged under my jurisdiction and was completed on (mo/day/year) June 1, 1984 and this record is true to the best of my knowledge and belief. Kansas Water Well Contractor's License No. 249 This Water Well Record was completed on (mo/day/yr) June 10, 1984 under the business name of Hunt Drilling Co by (signature) Walter A Hunt

INSTRUCTIONS: Use typewriter or ball point pen, PLEASE PRESS FIRMLY and PRINT clearly. Please fill in blanks, underline or circle the correct answers. Send top three copies to Kansas Department of Health and Environment, Division of Environment, Environmental Geology Section, Topeka, KS 66620. Send one to WATER WELL OWNER and retain one for your records.

OFFICE USE ONLY
T
35 R
4
BW
SEC. 5
SE 1/4
SE 1/4
NW 1/4

DP