
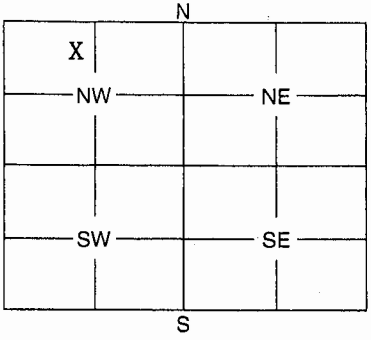


1	LOCATION OF WATER WELL:	Fraction	Section Number	Township Number	Range Number
	County: Cowley	NE 1/4 NW 1/4 NW 1/4	6	35	4 

Distance and direction from nearest town or city street address of well if located within city?
1800 S. Summit, Arkansas City, Kansas

2	WATER WELL OWNER: John Morrell & Co.	RR #, St. Address, Box #: 1400 N. Webber Ave.	Board of Agriculture, Division of Water Resources
	City, State, ZIP Code: Sioux Falls, SD 57103	Application Number:	

3	MARK WELL'S LOCATION WITH AN "X" IN SECTION BOX:	4	DEPTH OF WELL 9.2 ft.
		WELL'S STATIC WATER LEVEL Dry ft.	
		WELL WAS USED AS:	
		1 Domestic	5 Public Water Supply
		2 Irrigation	6 Oil Field Water Supply
		3 Feedlot	7 Domestic (Lawn & Garden)
		4 Industrial	8 Air Conditioning
			9 Dewatering
			<input checked="" type="radio"/> 10 Monitoring Well
			11 Injection Well
			12 Other
		Was a chemical / bacteriological sample submitted to Department? Yes No <input checked="" type="checkbox"/>	
		If yes, mo/day/yr sample was submitted	
		Water Well Disinfected: Yes No <input checked="" type="checkbox"/>	

5	TYPE OF BLANK CASING USED:			
	1 Steel	3 RMP (SR)	5 Wrought	7 Fiberglass
	<input checked="" type="radio"/> 2 PVC	4 ABS	6 Asbestos-Cement	8 Concrete Tile
	9 Other (Specify below)			
	Blank casing diameter 2 in.	Was casing pulled? Yes <input checked="" type="checkbox"/> No	If yes, how much 9.2'	
	Casing height above or below land surface n/a in.			

6	GROUT PLUG MATERIAL:	1 Neat cement	2 Cement grout	<input checked="" type="radio"/> 3 Bentonite	4 Other
	Grout Plug Intervals:	From 0 ft.	to 9.2 ft.,	From ft.	to ft., From to ft.
	What is the nearest source of possible contamination:				
	1 Septic tank	6 Seepage pit	<input checked="" type="radio"/> 7 Fuel storage	16 Other (specify below)	
	2 Sewer lines	7 Pit privy	12 Fertilizer storage	
	3 Watertight sewer lines	8 Sewage lagoon	13 Insecticide storage	
	4 Lateral lines	9 Feedyard	14 Abandoned water well	
	5 Cess pool	10 Livestock pens	15 Oil well/Gas well	
	Direction from well? Southwest	How many feet? 200			

FROM	TO	PLUGGING MATERIALS
0	9.2	Bentonite

KDHE Project Code 02018570
 GeoCore #220

RECEIVED

SEP 14 2004

MW7

BUREAU OF WATER

7	CONTRACTOR'S OF LANDOWNER'S CERTIFICATION: This water well was plugged under my jurisdiction and was completed on (mo/day/year) 8/25/2004 and this record is true to the best of my knowledge and belief. Kansas Water Well Contractor's License No. 527 This Water Well Record was completed on (mo/day/year) 9/13/04 under the business name of GeoCore, Inc. by (signature) <i>Dale A. Holt</i>
---	---

INSTRUCTIONS: Use typewriter or ball point pen. Please press firmly and print clearly. Please fill in blanks, underline or circle the correct answers. Send top three copies to Kansas Department of Health and Environment, Bureau of Water, Geology Section, 1000 SW Jackson St., Ste. 420, Topeka, Kansas 66612-1367. Telephone: 785/296-5522. Send one to Water Well Owner and retain one for your records.