

USE TYPEWRITER OR BALL POINT PEN-PRESS FIRMLY, PRINT CLEARLY.

WATER WELL RECORD
KSA 82a-1201-1215


T R EW sec 1/4 1/4 1/4 No.

Kansas State Dept. Of Health
(Water Well Contractors)
Forbes-Bldg. 740
Topeka, Kansas 66620

1 Location of well:	County Cowley	Township name Silverdale	Fraction E1/2 S 1/2	Section number 6	Town number 35 S	Range number 5 E
---------------------	-------------------------	------------------------------------	-------------------------------	----------------------------	----------------------------	----------------------------

Distance and direction from nearest town or city: **SE 1/4 3 1/2 miles SW from**
Street address of well location if in city: **Arkansas City, Kansas**

3 Owner of well: **Norman Bailey**
Address: **R.R. 3
Arkansas City, Kansas 67005**

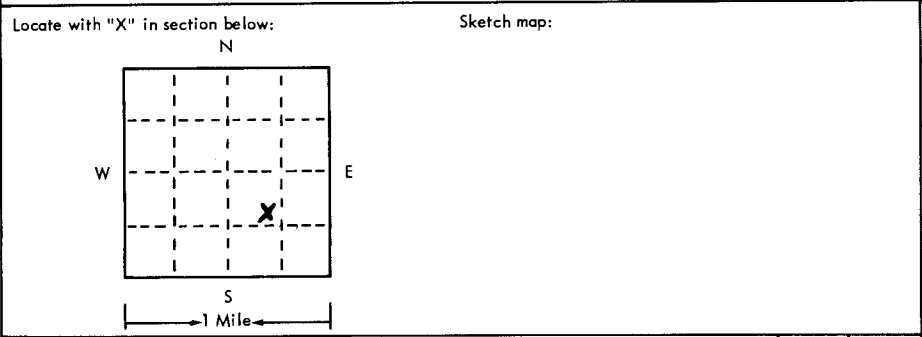

4 Well depth: 170 ft. Date of completion 3-27-76
Well diameter 10 in.

5 Cable tool Rotary Driven Dug
 Hollow rod Jetted Bored Reverse rotary

6 Use: Domestic Public supply Industry
 Irrigation Air conditioning Commercial
 Test well

7 Casing: Material None Height: above/below
Threaded Welded Surface in.
Diam. in. Weight lbs./ft.
 in. to ft. depth Drive shoe? Yes No
 in. to ft. depth

2	Type and color of material	From	To
	Top Soil	0	3
	Yellow colored Limestone	3	15
	Dark gray shale	15	30
	Cream colored lime	30	55
	Blue gray shale	55	66
	Red Clay	66	83
	Gray limestone	83	87
	Red clay & some sand	87	90
	Cream colored limestone	90	97
	Blue gray shale	97	113
	Blue gray soft clay	113	120
	Red clay	120	130
	Gray shale	130	135
	Cream colored limestone	135	140
	Brown clay	140	148
	Blue gray shale	148	160
	Gray limestone & fine sand (sandstone) <small>(Use a second sheet if needed)</small>	160	170

8 Screen: Manufacturer None
Type Dia.
Slot/gauze Length
Set between ft. and ft.
Fittings: Gravel pack Yes No Size range of material

9 Static water level: None
 ft. below land surface Date

10 Pumping level below land surfaces: None
 ft. after hrs. pumping g.p.m.
 ft. after hrs. pumping g.p.m.
Estimated maximum yield g.p.m.

11 Water sample submitted:
 Yes No Date

12 Well head completion: None
 Pitless adapter Inches above grade

13 Well grouted? Yes No
 Neat cement Bentonite
Depth: From ft. to ft.

14 Nearest source of possible contamination: Drainage
ft. 200 Direction South Type ditch
Well disinfected upon completion? Yes No

15 Pump: Not installed
Manufacturer's name
Model number HP Volts
Length of drop pipe ft. capacity g.m.p.
Type:
 Submersible Turbine
 Jet Reciprocating
 Centrifugal Other

16 Remarks: elevation This well was dry & plugged

Topography:
 Hill
 Slope
 Upland
 Valley

Water well contractor's certification:
This well was drilled under my jurisdiction and this report is true to the best of my knowledge and belief.

Eastman Drilling 299
Business name Box 115, Winfield, Kansas
Address
Signed Dale Eastman Date 4-1-76
Authorized representative

35 SE 6 E 1/2 S 1/2 SE 14