


1 LOCATION OF WATER WELL: County: CHAUTAUGUA Fraction: NE 1/4 NE 1/4 NE 1/4 Section Number: 2a Township Number: T 35 S Range Number: R 9 E

Distance and direction from nearest town or city street address of well if located within city?
1 1/4 mile E Howard, KS

2 WATER WELL OWNER: RICK
 RR#, St. Address, Box #: 105 JOHNSON ST
 City, State, ZIP Code: COPAN OK. 74022
 Board of Agriculture, Division of Water Resources
 Application Number:

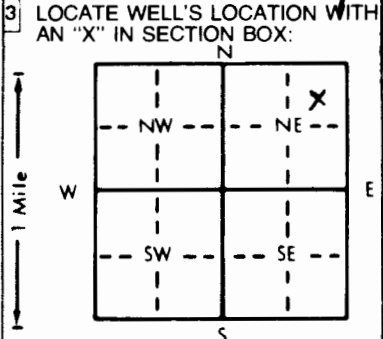

4 DEPTH OF COMPLETED WELL: 85 ft. ELEVATION:
 Depth(s) Groundwater Encountered 1. 60 ft. 2. ft. 3. ft.
 WELL'S STATIC WATER LEVEL: 25 ft. below land surface measured on mo/day/yr 5/22/97
 Pump test data: Well water was ft. after hours pumping gpm
 Est. Yield: 365 gpm; Well water was ft. after hours pumping gpm
 Bore Hole Diameter: 8 in. to 85 ft., and in. to ft.
 WELL WATER TO BE USED AS:
 Domestic 3 Feedlot 6 Oil field water supply 9 Dewatering 12 Other (Specify below)
 2 Irrigation 4 Industrial 7 Lawn and garden only 10 Monitoring well
 Was a chemical/bacteriological sample submitted to Department? Yes No ; If yes, mo/day/yr sample was submitted
 Water Well Disinfected? Yes No

5 TYPE OF BLANK CASING USED:
 1 Steel 3 RMP (SR) 5 Wrought iron 8 Concrete tile CASING JOINTS: Glued Clamped
 PVC 4 ABS 7 Fiberglass Welded
 Blank casing diameter: 5 in. to 80.65 ft., Dia. in. to ft., Dia. in. to ft.
 Casing height above land surface: 12 in., weight lbs./ft. Wall thickness or gauge No.
 TYPE OF SCREEN OR PERFORATION MATERIAL:
 1 Steel 3 Stainless steel 5 Fiberglass PVC 8 RMP (SR) 11 Other (specify)
 2 Brass 4 Galvanized steel 6 Concrete tile 9 ABS 12 None used (open hole)
 SCREEN OR PERFORATION OPENINGS ARE:
 1 Continuous slot 3 Mill slot 5 Gauzed wrapped 8 Saw cut 11 None (open hole)
 2 Louvered shutter 4 Key punched 6 Wire wrapped 9 Drilled holes
 7 Torch cut 10 Other (specify)
 SCREEN-PERFORATED INTERVALS: From 85 ft. to 65 ft., From ft. to ft.
 From ft. to ft., From ft. to ft.
 GRAVEL PACK INTERVALS: From 85 ft. to 30 ft., From ft. to ft.
 From ft. to ft., From ft. to ft.

6 GROUT MATERIAL: Neat cement 2 Cement grout Bentonite 4 Other
 Grout Intervals: From 0 ft. to 830 ft., From ft. to ft., From ft. to ft.
 What is the nearest source of possible contamination:
 1 Septic tank 4 Lateral lines 7 Pit privy 10 Livestock pens 14 Abandoned water well
 2 Sewer lines 5 Cess pool 8 Sewage lagoon 11 Fuel storage 15 Oil well/Gas well
 3 Watertight sewer lines 6 Seepage pit 9 Feedyard 12 Fertilizer storage 16 Other (specify below)
 13 Insecticide storage
 Direction from well? How many feet? MOBILE HOME 150ft.

FROM	TO	LITHOLOGIC LOG	FROM	TO	PLUGGING INTERVALS
0	2	soil			
2	25	YELLOW CLAY			
25	30	GRAY SHALE			
25	35	GRAY SHALE			
35	37	GRAY SHALE			
37	48	LIME STONE			
48	60	BROWN SAND STONE			
60	68	LIME STONE			
68	70	WHITE SAND STONE			
70	85	GRAY SHALE			

7 CONTRACTOR'S OR LANDOWNER'S CERTIFICATION: This water well was constructed, (2) reconstructed, or (3) plugged under my jurisdiction and was completed on (mo/day/year) 5-22-97 and this record is true to the best of my knowledge and belief. Kansas Water Well Contractor's License No. 501 This Water Well Record was completed on (mo/day/yr) 5-24-97 under the business name of Callie Water Well Service by (signature) Dennett M Callie

OFFICE USE ONLY
T
R
EM
SEC.
1/4
1/4
1/4