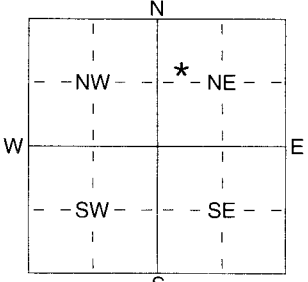


1 LOCATION OF WATER WELL: Fraction **SW 1/4 NW 1/4 NE 1/4** Section Number **11** Township Number **T 3 S** Range Number **R 1 EW**
 County: **Washington**

Distance and direction from nearest town or city street address of well if located within city?
3 South, 1/2 East & 1/4 South of Haddam

2 WATER WELL OWNER: **Jack Allen**
 RR#, St. Address, Box # : **408 Chase** Board of Agriculture, Division of Water Resources
 City, State, ZIP Code : **Haddam, KS 66944** Application Number:

3 LOCATE WELL'S LOCATION WITH AN "X" IN SECTION BOX:

 4 DEPTH OF COMPLETED WELL **120** ft. ELEVATION:
 Depth(s) Groundwater Encountered 1 ft. 2 ft. 3 ft.
 WELL'S STATIC WATER LEVEL **9.0** ft. below land surface measured on mo/day/yr **11/13/02**
 Pump test data: Well water was ft. after hours pumping gpm
 Est. Yield **10** gpm: Well water was ft. after hours pumping gpm
 WELL WATER TO BE USED AS: 5 Public water supply 8 Air conditioning 11 Injection well
 1 Domestic 3 Feedlot 6 Oil field water supply 9 Dewatering 12 Other (Specify below)
 2 Irrigation 4 Industrial 7 Domestic (lawn & garden) 10 Monitoring well
 Was a chemical/bacteriological sample submitted to Department? Yes No *****; If yes, mo/day/yr sample was submitted
 Water Well Disinfected? Yes ***** No

5 TYPE OF BLANK CASING USED:
 1 Steel 3 RMP (SR) 5 Wrought iron 8 Concrete tile CASING JOINTS: Glued ***** Clamped
 2 PVC 4 ABS 6 Asbestos-Cement 9 Other (specify below) Welded
 7 Fiberglass Threaded
 Blank casing diameter **5** in. to **1.00** ft. Dia in. to ft. Dia in. to ft.
 Casing height above land surface **18** in., weight **200** lbs./ft. Wall thickness or guage No. **.265**
 TYPE OF SCREEN OR PERFORATION MATERIAL:
 1 Steel 3 Stainless Steel 5 Fiberglass 7 PVC 10 Asbestos-Cement
 2 Brass 4 Galvanized Steel 6 Concrete tile 8 RMP (SR) 11 Other (Specify)
 9 ABS 12 None used (open hole)
 SCREEN OR PERFORATION OPENINGS ARE:
 1 Continuous slot 3 Mill slot 5 Guazed wrapped 8 Saw cut 11 None (open hole)
 2 Louvered shutter 4 Key punched 6 Wire wrapped 9 Drilled holes
 7 Torch cut 10 Other (specify) ft.
 SCREEN-PERFORATED INTERVALS: From **100** ft. to **120** ft. From ft. to ft.
 GRAVEL PACK INTERVALS: From **30** ft. to **120** ft. From ft. to ft.

6 GROUT MATERIAL: 1 Neat cement 2 Cement grout **3 Bentonite** 4 Other
 Grout Intervals: From **5** ft. to **30** ft. From ft. to ft. From ft. to ft.
 What is the nearest source of possible contamination:
 1 Septic tank 4 Lateral lines 7 Pit privy 10 Livestock pens 14 Abandoned water well
 2 Sewer lines 5 Cess pool 8 Sewage lagoon 11 Fuel storage 15 Oil well/Gas well
 3 Watertight sewer lines 6 Seepage pit 9 Feedyard 12 Fertilizer storage 16 Other (specify below)
 13 Insecticide storage
 Direction from well? **East** How many feet? **100**

FROM	TO	LITHOLOGIC LOG	FROM	TO	PLUGGING INTERVALS
0	3	Brown Clay & Limestone			
3	16	Yellow Clay & Limestone			
16	99	Gray Shale			
99	109	Sandstone (Gray)			
109	122	Gray Shale			

7 CONTRACTOR'S OR LANDOWNER'S CERTIFICATION: This water well was (1) constructed, (2) reconstructed, or (3) plugged under my jurisdiction and was completed on (mo/day/year) **11/13/02** and this record is true to the best of my knowledge and belief. Kansas Water Well Contractor's Licence No **51.8** This Water Well Record was completed on (mo/day/yr) **11/20/02** under the business name of **Blue Valley Drilling** by (signature) *Chris Stahl*

INSTRUCTIONS: Use typewriter or ball point pen. PLEASE PRESS FIRMLY and PRINT clearly. Please fill in blanks, underline or circle the correct answers. Send top three copies to Kansas Department of Health and Environment, Bureau of Water, Geology Section, 1000 SW Jackson St., Suite 420, Topeka, Kansas 66612-1367. Telephone 785-296-5522. Send one to WATER WELL OWNER and retain one for your records. Fee of \$5.00 for each constructed well.