14

USE TYPEWRITER OR BALL POINT PEN-PRESS FIRMLY, PRINT CLEARLY.

WATER WELL RECORD
KSA 82a-1201-1215

Kansas Department of Health and Environment-Division of Environment
(Water well Contractors)
Topeka, Kansas 66620

1. Location of well:	County	Fraction	Section number	Township number	Range number
	WASHINGTON	SE ~~SW NW NE~~ 1/4	9	T 3 S	R 1 E/W

2. Distance and direction from nearest town or city: 3 S 1½ W
Street address of well location if in city: HADDAM

3. Owner of well: WILLIAM KELLER
R.R. or street: RR #2
City, state, zip code: HADDAM, KANS 66944

4. Locate with "X" in section below:

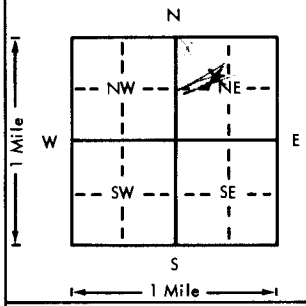

Sketch map:

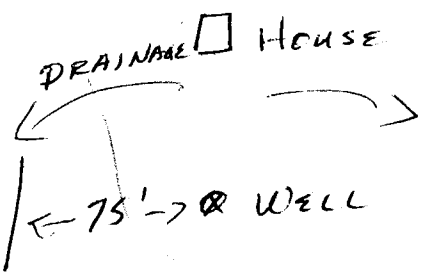

6. Bore hole dia. 8 in. Completion date
Well depth 181 ft. 3/19/76

7. ___ Cable tool X Rotary ___ Driven ___ Dug
___ Hollow rod ___ Jetted ___ Bored ___ Reverse rotary

8. Use: X Domestic ___ Public supply ___ Industry
___ Irrigation ___ Air conditioning ___ Stock
___ Lawn ___ Oil field water ___ Other

9. Casing: Material PVC Height: Above or below
Threaded ___ Welded X Surface 15 in.
RMP ___ PVC X Weight 3 lbs./ft.
Dia. 5 in. to 181 ft. depth Wall Thickness: inches or
Dia. ___ in. to ___ ft. depth gage No. ~~40 SH~~

10. Screen: Manufacturer's name 1214 PUMP CO
Type PVC Dia. 5"
Slot/gauze 1/16" Length 20'
Set between 181 ft. and 161 ft.
___ ft. and ___ ft.
Gravel pack? Yes Size range of material ~~1/8 x 1/4~~

11. Static water level: mo./day/yr.
150 ft. below land surface Date 3/19/76

12. Pumping level below land surface:
___ ft. after ___ hrs. pumping N/A ___ g.p.m.
___ ft. after ___ hrs. pumping ___ g.p.m.
Estimated maximum yield 20 g.p.m.

13. Water sample submitted: mo./day/yr.
___ Yes X No Date

14. Well head completion:
___ Pitless adapter X Inches above grade

15. Well grouted? Yes
With: X Neat cement ___ Bentonite ___ Concrete
Depth: From 0 ft. to 10 ft. MHC

16. Nearest source of possible contamination:
ft. 75 Direction EAST Type LOTS
Well disinfected upon completion? X Yes ___ No

17. Pump: X Not installed
Manufacturer's name
Model number HP Volts
Length of drop pipe ft. capacity g.p.m.
Type:
___ Submersible ___ Turbine
___ Jet ___ Reciprocating
___ Centrifugal ___ Other

5. Type and color of material

	From	To
TOPSOIL	0	2
BROWN CLAY	2	9
BROWN CLAY W/ LIMESTONE LAYERS	9	25
BLUE CLAY	25	116
BLUE CLAY W/ SANDROCK LAYERS	116	124
BROWN SANDROCK	124	170
HARD ROCK	170	171
SANDROCK	171	180
RED SHALE	180	185
STOP	185	

(Use a second sheet if needed)

18. Elevation: 1611
Topography:
X Hill
___ Slope
___ Upland
___ Valley

19. Remarks:

20. Water well contractor's certification:
This well was drilled under my jurisdiction and this report is true to the best of my knowledge and belief.
GEO COX & SONS INC 258
Business name License No.
Address CLIFTON KANS 66937
Signed Wayne Cox Date
Authorized representative

T 3 R 1 E/W Sec 9 SE ~~NW~~ NE 1/4 1/4 1/4

Forward the white, blue and pink copies to the Department of Health and Environment

Form WWC-5

MI-1023