


1 LOCATION OF WATER WELL: County: Washington Fraction NW 1/4 NE 1/4 NE 1/4 Section Number 16 Township Number T 3 S Range Number R 1 E W

Distance and direction from nearest town or city street address of well if located within city?
2 South, 1 West, 1 South, 1/4 West of Haddam

2 WATER WELL OWNER: Albert Ryser
 RR#, St. Address, Box # : Roural Route Board of Agriculture, Division of Water Resources
 City, State, ZIP Code : Haddam, Kansas 66944 Application Number:

3 LOCATE WELL'S LOCATION WITH AN "X" IN SECTION BOX:

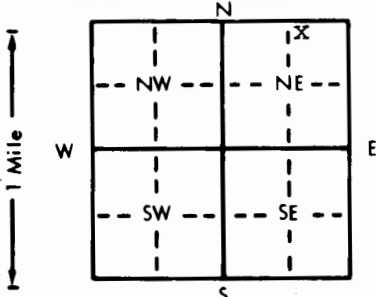

4 DEPTH OF COMPLETED WELL: 59 ft. ELEVATION: 1740
 Depth(s) Groundwater Encountered 1. 7 ft. 2. _____ ft. 3. _____ ft.
 WELL'S STATIC WATER LEVEL: 7 ft. below land surface measured on mo/day/yr 4/1/1982
 Pump test data: Well water was NA ft. after _____ hours pumping _____ gpm
 Est. Yield 10 gpm: Well water was _____ ft. after _____ hours pumping _____ gpm
 Bore Hole Diameter: 8 in. to 59 ft., and _____ in. to _____ ft.
 WELL WATER TO BE USED AS:
 1 Domestic 3 Feedlot 6 Oil field water supply 9 Dewatering 12 Other (Specify below)
 2 Irrigation 4 Industrial 7 Lawn and garden only 10 Observation well
 Was a chemical/bacteriological sample submitted to Department? Yes _____ No ; If yes, mo/day/yr sample was submitted _____
 Water Well Disinfected? Yes No

5 TYPE OF BLANK CASING USED:
 1 Steel 3 RMP (SR) 5 Wrought iron 8 Concrete tile CASING JOINTS: Glued Clamped _____
 2 PVC 4 ABS 6 Asbestos-Cement 9 Other (specify below) Welded _____
 7 Fiberglass Threaded _____
 Blank casing diameter: 5.29 in. to 29 ft., Dia _____ in. to _____ ft., Dia _____ in. to _____ ft.
 Casing height above land surface: 12 in., weight 3 lbs./ft. Wall thickness or gauge No. 258
 TYPE OF SCREEN OR PERFORATION MATERIAL:
 1 Steel 3 Stainless steel 5 Fiberglass 7 PVC 10 Asbestos-cement
 2 Brass 4 Galvanized steel 6 Concrete tile 8 RMP (SR) 11 Other (specify) _____
 9 ABS 12 None used (open hole)
 SCREEN OR PERFORATION OPENINGS ARE:
 1 Continuous slot 3 Mill slot 5 Gauzed wrapped 8 Saw cut 11 None (open hole)
 2 Louvered shutter 4 Key punched 6 Wire wrapped 9 Drilled holes
 7 Torch cut 10 Other (specify) _____
 SCREEN-PERFORATED INTERVALS:
 From 29 ft. to 59 ft., From _____ ft. to _____ ft.
 From 10 ft. to 30 ft., From _____ ft. to _____ ft.
 GRAVEL PACK INTERVALS:
 From 10 ft. to 60 ft., From _____ ft. to _____ ft.
 From _____ ft. to _____ ft., From _____ ft. to _____ ft.

6 GROUT MATERIAL: 1 Neat cement 2 Cement grout 3 Bentonite 4 Other _____
 Grout Intervals: From 0 ft. to 10 ft., From _____ ft. to _____ ft., From _____ ft. to _____ ft.
 What is the nearest source of possible contamination:
 1 Septic tank 4 Lateral lines 10 Livestock pens 14 Abandoned water well
 2 Sewer lines 5 Cess pool 11 Fuel storage 15 Oil well/Gas well
 3 Watertight sewer lines 6 Seepage pit 8 Sewage lagoon 12 Fertilizer storage 16 Other (specify below)
 9 Feedyard 13 Insecticide storage
 Direction from well? North How many feet? 75

FROM	TO	LITHOLOGIC LOG	FROM	TO	LITHOLOGIC LOG
0	3	topsoil			
3	7	brown clay			
7	9	limestone			
9	21	blue clay			
21	36	brown clay			
36	38	blue shale			
38	40	hard rock			
40	56	brown shale			
56	57	limestone			
57	60	blue shale			
60		stop			

7 CONTRACTOR'S OR LANDOWNER'S CERTIFICATION: This water well was constructed, (2) reconstructed, or (3) plugged under my jurisdiction and was completed on (mo/day/year) 4/1/1982 and this record is true to the best of my knowledge and belief. Kansas Water Well Contractor's License No. 359. This Water Well Record was completed on (mo/day/yr) 4/15/1982 under the business name of Daryl Cox & Sons Inc. by (signature) Daryl Cox

INSTRUCTIONS: Use typewriter or ball point pen, PLEASE PRESS FIRMLY and PRINT clearly. Please fill in blanks, underline or circle the correct answers. Send top three copies to Kansas Department of Health and Environment, Division of Environment, Environmental Geology Section, Topeka, KS 66620. Send one to WATER WELL OWNER and retain one for your records.

OFFICE USE ONLY

SEC 16

NW 1/4 NE 1/4 NE 1/4