


1	LOCATION OF WATER WELL:	Fraction	Section Number	Township Number	Range Number
County: <u>Nemaha</u>		<u>NE 1/4 NW 1/4 NE 1/4</u>	<u>29</u>	<u>3</u>	<u>12</u>

Distance and direction from nearest town or city street address of well if located within city? _____

2 WATER WELL OWNER: Lynn Rottinghaus
 RR#, St. Address, Box #: RR1 Box 89 Board of Agriculture, Division of Water Resources
 City, State, ZIP Code: Centralia, KS 66415 Application Number: _____

3 MARK WELL'S LOCATION WITH AN "X" IN SECTION BOX:

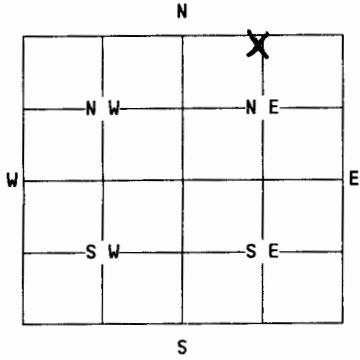

4 DEPTH OF WELL... 28ft.
 WELL'S STATIC WATER LEVEL... 12ft.

- WELL WAS USED AS:
- | | | |
|--------------|--------------------------|--------------------------------|
| 1 Domestic | 5 Public Water Supply | 9 Dewatering |
| 2 Irrigation | 6 Oil Field Water Supply | 10 Monitoring Well |
| 3 Feedlot | 7 Lawn and Garden Only | 11 Injection Well |
| 4 Industrial | 8 Air Conditioning | 12 Other: <u>Assture</u> |

Was a chemical/bacteriological sample submitted to Department? Yes... No... X
 If yes, mo/day/yr sample was submitted: _____
 Water Well Disinfected: Yes... X... No.....

5 TYPE OF BLANK CASING USED:

1 Steel	3 RMP (SR)	5 Wrought	7 Fiberglass	9 Other (specify below)
2 PVC	4 ABS	6 Asbestos-Cement	8 Concrete Tile	<u>Clay Tile</u>

Blank casing diameter... 10in. Was casing pulled? Yes... X... No... . If yes, how much... _____
 Casing height above or below land surface... 6 1/2 ftin. 6 1/2 ft

6 GROUT PLUG MATERIAL: 1 Neat cement 2 Cement grout 3 Bentonite 4 Other.....
 Grout Plug Intervals: From... 8 .ft. to... 4 .ft., From.....ft. toft., From..... to.....ft.
 What is the nearest source of possible contamination:

1 Septic tank	6 Seepage pit	11 Fuel storage	16 Other (specify below)
2 Sewer lines	7 Pit privy	12 Fertilizer storage	<u>Field Runoff</u>
3 Watertight sewer lines	8 Sewage lagoon	13 Insecticide storage	
4 Lateral lines	9 Feedyard	14 Abandoned water well	
5 Cess Pool	10 Livestock pens	15 Oil well/Gas well	

Direction from well? ... West How many feet? ... 30

FROM	TO	PLUGGING MATERIALS
<u>28</u>	<u>12</u>	<u>sand</u>
<u>12</u>	<u>8</u>	<u>Clay subsoil</u>
<u>8</u>	<u>4</u>	<u>Bentonite</u>
<u>4</u>	<u>0</u>	<u>Topsoil</u>

A local contractor dug this well down around 6 ft. This is how I removed about 6 ft of casing.

7 CONTRACTOR'S OR LANDOWNER'S CERTIFICATION: This water well was plugged under my jurisdiction and was completed on (mo/day/year)... 12/12/94 ... and this record is true to the best of my knowledge and belief. Kansas Water Well Contractor's License No. This Water Well Record was completed on (mo/day/year) 12/12/94 ... under the business name of: _____ by (signature) ... Lynn Rottinghaus

INSTRUCTIONS: Use typewriter or ball point pen. Please press firmly and print clearly. Please fill in blanks, underline or circle the correct answers. Send top three copies to Kansas Department of Health and Environment, Bureau of Water, Topeka, Kansas 66620-0001. Telephone: 913/296-3565. Send one to Water Well Owner and retain one for your records.