


1 LOCATION OF WATER WELL: Fraction SW 1/4 SE 1/4 SE 1/4 Section Number 18 Township Number T 3 S Range Number R 14 E
 County: Nemaha

Distance and direction from nearest town or city street address of well if located within city?
1 1/2 west Woodlawn Ks

2 WATER WELL OWNER: GARY BAUERLE
 RR#, St. Address, Box #: RT. 4 Box 40 Board of Agriculture, Division of Water Resources
 City, State, ZIP Code: Sabetha, Ks 66534 Application Number:

3 LOCATE WELL'S LOCATION WITH AN "X" IN SECTION BOX:
 4 DEPTH OF COMPLETED WELL: 74 ft. ELEVATION: _____

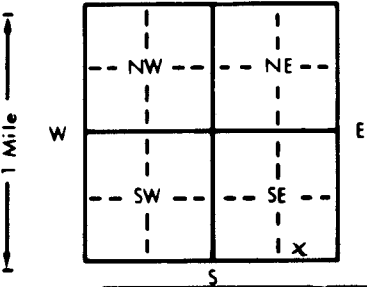

Depth(s) Groundwater Encountered 1. 31 ft. 2. _____ ft. 3. _____ ft.
 WELL'S STATIC WATER LEVEL 9 ft. below land surface measured on mo/day/yr 12-11-89
 Pump test data: Well water was 30 ft. after 3 hours pumping 15 gpm
 Est. Yield 30 gpm: Well water was _____ ft. after _____ hours pumping _____ gpm
 Bore Hole Diameter 9 in. to 74 ft., and _____ in. to _____ ft.
 WELL WATER TO BE USED AS:
 1 Domestic 3 Feedlot 6 Oil field water supply 9 Dewatering 12 Other (Specify below)
 2 Irrigation 4 Industrial 7 Lawn and garden only 10 Observation well
 Was a chemical/bacteriological sample submitted to Department? Yes _____ No ; If yes, mo/day/yr sample was submitted _____
 Water Well Disinfected? Yes No _____

5 TYPE OF BLANK CASING USED:
 1 Steel 3 RMP (SR) 5 Wrought iron 8 Concrete tile CASING JOINTS: Glued Clamped _____
 2 PVC 4 ABS 6 Asbestos-Cement 9 Other (specify below) _____ Welded _____
 7 Fiberglass _____ Threaded _____

Blank casing diameter 5 in. to 64 ft., Dia _____ in. to _____ ft., Dia _____ in. to _____ ft.
 Casing height above land surface 18 in., weight 2943 lbs./ft. Wall thickness or gauge No. S.P.R. 2.1

TYPE OF SCREEN OR PERFORATION MATERIAL:
 1 Steel 3 Stainless steel 5 Fiberglass 7 PVC 10 Asbestos-cement
 2 Brass 4 Galvanized steel 6 Concrete tile 8 RMP (SR) 11 Other (specify) _____
 12 None used (open hole)

SCREEN OR PERFORATION OPENINGS ARE:
 1 Continuous slot 3 Mill slot 5 Gauzed wrapped 8 Saw cut 11 None (open hole)
 2 Louvered shutter 4 Key punched 6 Wire wrapped 9 Drilled holes
 7 Torch cut 10 Other (specify) _____

SCREEN-PERFORATED INTERVALS: From 64 ft. to 74 ft., From _____ ft. to _____ ft.
 From _____ ft. to _____ ft., From _____ ft. to _____ ft.
 GRAVEL PACK INTERVALS: From 17 ft. to 74 ft., From _____ ft. to _____ ft.
 From _____ ft. to _____ ft., From _____ ft. to _____ ft.

6 GROUT MATERIAL: 1 Neat cement 2 Cement grout 3 Bentonite 4 Other _____
 Grout intervals: From 41 ft. to 17 ft., From _____ ft. to _____ ft., From _____ ft. to _____ ft.

What is the nearest source of possible contamination:
 1 Septic tank 4 Lateral lines 7 Pit privy 10 Livestock pens 14 Abandoned water well
 2 Sewer lines 5 Cess pool 8 Sewage lagoon 11 Fuel storage 15 Oil well/Gas well
 3 Watertight sewer lines 6 Seepage pit 9 Feedyard 12 Fertilizer storage 16 Other (specify below)
 13 Insecticide storage _____
 Direction from well? North west How many feet? 30'

FROM	TO	LITHOLOGIC LOG	FROM	TO	LITHOLOGIC LOG
0	4	NS			
4	12	Silty clay BR			
12	17	SANDY clay GRAY			
17	31	SANDY clay GRAY			
31	32	SAND BR VF - F some c			
32	36	SANDY clay BR			
36	41	SANDY clay GRAY			
41	41.5	SAND GRAY VF - GRAVEL			
41.5	46	SANDY clay GRAY			
46	47	SANDY clay BR			
47	62	SAND BR VF - c some gravel			
62	74	SAND BR VF - med some gravel			

7 CONTRACTOR'S OR LANDOWNER'S CERTIFICATION: This water well was (1) constructed, (2) reconstructed, or (3) plugged under my jurisdiction and was completed on (mo/day/year) 12-11-89 and this record is true to the best of my knowledge and belief. Kansas
 Water Well Contractor's License No. 308 This Water Well Record was completed on (mo/day/yr) 12-11-89
 under the business name of Rioschick Drilling Co by (signature) Ray Rioschick

INSTRUCTIONS: Use typewriter or ball point pen. PLEASE PRESS FIRMLY and PRINT clearly. Please fill in blanks, underline or circle the correct answers. Send top three copies to Kansas Department of Health and Environment, Bureau of Water Protection, Topeka, Kansas 66620-7320. Telephone: 913-862-9360. Send one to WATER WELL OWNER and retain one for your records.

OFFICE USE ONLY
T
R
EAW
SEC.