


LOCATION OF WATER WELL: County: Kanaha 666 Fraction: SE 1/4 NE 1/4 NW 1/4 Section Number: 20 Township Number: T 3 S Range Number: R 14 E

Distance and direction from nearest town or city street address of well if located within city?
8 South of 4 West Sabetha KS

WATER WELL OWNER: MARVIN LIEBZ RR#, St. Address, Box #: Sabetha KS 66534 Board of Agriculture, Division of Water Resources

City, State, ZIP Code: Sabetha KS 66534 Application Number:

LOCATE WELL'S LOCATION WITH AN "X" IN SECTION BOX:

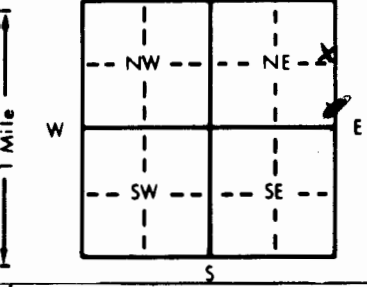

DEPTH OF COMPLETED WELL: 5.2 ft. ELEVATION: 38 ft.

Depth(s) Groundwater Encountered 1. 3.8 ft. 2. 9.7 ft. 3. 9.7 ft.
 WELL'S STATIC WATER LEVEL 9.7 ft. below land surface measured on mo/day/yr
 Pump test data: Well water was 1.5 ft. after 8 hours pumping 1.5 gpm
 Est. Yield 1.5 gpm: Well water was 5.2 ft. after 8 hours pumping 1.5 gpm
 Bore Hole Diameter 8 in. to 5.2 ft., and 5.2 in. to 5.2 ft.

WELL WATER TO BE USED AS:
 Domestic 3 Feedlot 6 Oil field water supply 9 Dewatering 12 Other (Specify below)
 2 Irrigation 4 Industrial 7 Lawn and garden only 10 Observation well

Was a chemical/bacteriological sample submitted to Department? Yes X No X; If yes, mo/day/yr sample was submitted
 Water Well Disinfected? Yes X No X

TYPE OF BLANK CASING USED:
 1 Steel 2 PVC 3 RMP (SR) 4 ABS 5 Wrought iron 6 Asbestos-Cement 7 Fiberglass 8 Concrete tile 9 Other (specify below) CASING JOINTS: Glued X Clamped X Welded X Threaded X

 Casing height above land surface 8.4 in., weight 2.843 lbs./ft. Wall thickness or gauge No. 0.265

TYPE OF SCREEN OR PERFORATION MATERIAL:
 1 Steel 2 Brass 3 Stainless steel 4 Galvanized steel 5 Fiberglass 6 Concrete tile 7 RMP (SR) 8 ABS 9 Other (specify below) 10 Asbestos-cement 11 Other (specify below) 12 None used (open hole)

SCREEN OR PERFORATION OPENINGS ARE:
 1 Continuous slot 2 Louvered shutter 3 Mill slot 4 Key punched 5 Gauzed wrapped 6 Wire wrapped 7 Torch cut 8 Saw cut 9 Drilled holes 10 Other (specify below) 11 None (open hole)



GROUT MATERIAL: 1 Neat cement 2 Cement grout 3 Bentonite 4 Other


What is the nearest source of possible contamination:
 1 Septic tank 2 Sewer lines 3 Watertight sewer lines 4 Lateral lines 5 Cess pool 6 Seepage pit 7 Pit privy 8 Sewage lagoon 9 Feedyard 10 Livestock pens 11 Fuel storage 12 Fertilizer storage 13 Insecticide storage 14 Abandoned water well 15 Oil well/Gas well 16 Other (specify below) 800 ft

Direction from well? How many feet?

FROM	TO	LITHOLOGIC LOG	FROM	TO	LITHOLOGIC LOG
0	5	5" ϕ 1" NS			
5	18	silty clay Br			
18	27	2" ϕ 3" silty clay gray			
27	38	3" ϕ 1" clay bluish gray			
38	42	4" ϕ 5" sand gray VP - coarse			
42	52	5" ϕ 4" sandy clay gray			

CONTRACTOR'S OR LANDOWNER'S CERTIFICATION: This water well was (1) constructed, (2) reconstructed, or (3) plugged under my jurisdiction and was completed on (mo/day/year) 3-26-88 and this record is true to the best of my knowledge and belief. Kansas

Water Well Contractor's License No. 308 This Water Well Record was completed on (mo/day/yr) 4-20-88

under the business name of Bioschick Drilling Co by (signature) Ray Bioschick

INSTRUCTIONS: Use typewriter or ball point pen. PLEASE PRESS FIRMLY and PRINT clearly. Please fill in blanks, underline or circle the correct answers. Send top three copies to Kansas Department of Health and Environment, Bureau of Water Protection, Topeka, Kansas 66620-7320, Telephone: 913-862-9360. Send one to WATER WELL OWNER and retain one for your records.

OFFICE USE ONLY
 T
 3
 R
 14
 GEN
 SEC. 20
 SE 1/4
 NE 1/4
 NE 1/4