


1 LOCATION OF WATER WELL: County: Nemaha Fraction: SE 1/4 SE 1/4 SW 1/4 Section Number: 28 Township Number: T 3 S Range Number: R 14 E

Distance and direction from nearest town or city street address of well if located within city?
2 South 1/2 EAST WOODLAWN ISS

2 WATER WELL OWNER: George Tinklin
RR#, St. Address, Box #: Rt 4 BOX 80 Board of Agriculture, Division of Water Resources
City, State, ZIP Code: Sabetha Iss 66534 Application Number:

3 LOCATE WELL'S LOCATION WITH AN "X" IN SECTION BOX:

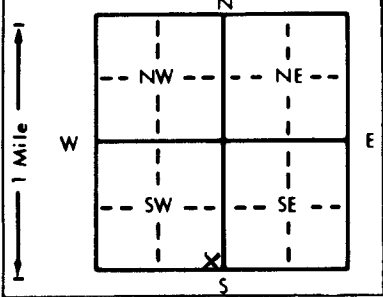

4 DEPTH OF COMPLETED WELL: 7.9 ft. ELEVATION:
Depth(s) Groundwater Encountered 1. 2.6 ft. 2. ft. 3. ft.
WELL'S STATIC WATER LEVEL: 2.6 ft. below land surface measured on mo/day/yr 4-25-92
Pump test data: Well water was ft. after hours pumping gpm
Est. Yield 1.0 gpm: Well water was ft. after hours pumping gpm
Bore Hole Diameter: 9 in. to 7.9 ft., and in. to ft.
WELL WATER TO BE USED AS: 5 Public water supply 8 Air conditioning 11 Injection well
Domestic 3 Feedlot 6 Oil field water supply 9 Dewatering 12 Other (Specify below)
2 Irrigation 4 Industrial 7 Lawn and garden only 10 Monitoring well
Was a chemical/bacteriological sample submitted to Department? Yes No X; If yes, mo/day/yr sample was submitted
Water Well Disinfected? Yes 1 No

5 TYPE OF BLANK CASING USED: 5 Wrought iron 8 Concrete tile CASING JOINTS: Glued ✓ Clamped
1 Steel 3 RMP (SR) 6 Asbestos-Cement 9 Other (specify below) Welded
2 PVC 4 ABS 7 Fiberglass Threaded
Blank casing diameter: 5 in. to 3.4 ft., Dia. in. to ft., Dia. in. to ft.
Casing height above land surface: 1.2 in., weight 2,843 lbs./ft. Wall thickness or gauge No. 3 D.R. 21

TYPE OF SCREEN OR PERFORATION MATERIAL: PVC 10 Asbestos-cement
1 Steel 3 Stainless steel 5 Fiberglass 8 RMP (SR) 11 Other (specify)
2 Brass 4 Galvanized steel 6 Concrete tile 9 ABS 12 None used (open hole)

SCREEN OR PERFORATION OPENINGS ARE: 5 Gauzed wrapped 8 Saw cut 11 None (open hole)
1 Continuous slot 3 Mill slot 6 Wire wrapped 9 Drilled holes
2 Louvered shutter 4 Key punched 7 Torch cut 10 Other (specify)

SCREEN-PERFORATED INTERVALS: From 3.4 ft. to 6.4 ft., From ft. to ft.
From ft. to ft., From ft. to ft.
GRAVEL PACK INTERVALS: From 2.4 ft. to 7.9 ft., From ft. to ft.
From ft. to ft., From ft. to ft.

6 GROUT MATERIAL: 1 Neat cement 2 Cement grout 3 Bentonite 4 Other
Grout Intervals: From 3 ft. to 2.4 ft., From ft. to ft., From ft. to ft.

What is the nearest source of possible contamination:
1 Septic tank 4 Lateral lines 7 Pit privy 10 Livestock pens 14 Abandoned water well
2 Sewer lines 5 Cess pool 8 Sewage lagoon 11 Fuel storage 15 Oil well/Gas well
3 Watertight sewer lines 6 Seepage pit 9 Feedyard 12 Fertilizer storage 16 Other (specify below)
13 Insecticide storage None known

FROM	TO	LITHOLOGIC LOG	FROM	TO	PLUGGING INTERVALS
0	5	NS			
5	12	SANDY CLAY BR			
12	24	SANDY CLAY YELLOW BR			
24	26	SAND BR VF-med			
26	40	SAND BR VF-C			
40	50	SAND BR VF-C			
50	58	SAND BR VF-F			
58	62	SANDY CLAY YELLOW BR			
62	64	SAND & GRAVEL BR			
64	79	SANDY CLAY GRAY			

7 CONTRACTOR'S OR LANDOWNER'S CERTIFICATION: This water well was (1) constructed, (2) reconstructed, or (3) plugged under my jurisdiction and was completed on (mo/day/year) 4-25-92 and this record is true to the best of my knowledge and belief. Kansas Water Well Contractor's License No. 308 This Water Well Record was completed on (mo/day/yr) 4-25-92 under the business name of Rieschick Drilling Co. by (signature) Ray Rieschick