


1 LOCATION OF WATER WELL: Fraction NW 1/4 NE 1/4 NE 1/4 Section Number 30 Township Number T 3 S Range Number R 14 E
 County: Neosho

Distance and direction from nearest town or city street address of well if located within city?
1 South 1/4 west Wood Lawn, KS.

2 WATER WELL OWNER: ERNEST McCLAIN JR.
 RR#, St. Address, Box #: Rt 2
 City, State, ZIP Code: GUFF KS. 66429
 Board of Agriculture, Division of Water Resources
 Application Number:

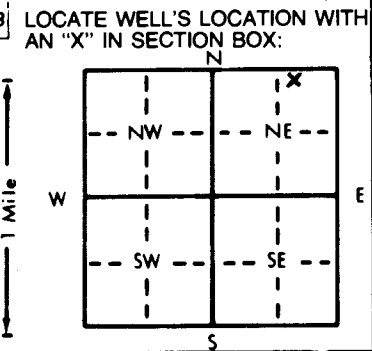

4 DEPTH OF COMPLETED WELL: 7.6 ft. ELEVATION:
 Depth(s) Groundwater Encountered 1. 49.5 ft. 2. ft. 3. ft.
 WELL'S STATIC WATER LEVEL: 1.5 ft. below land surface measured on mo/day/yr
 Pump test data: Well water was 5.9 ft. after 1 hours pumping 1.5 gpm
 Est. Yield 1.5 gpm: Well water was ft. after hours pumping gpm
 Bore Hole Diameter: 8 in. to 7.6 ft., and in. to ft.
 WELL WATER TO BE USED AS:
 1 Domestic 3 Feedlot 6 Oil field water supply 9 Dewatering 12 Other (Specify below)
 2 Irrigation 4 Industrial 7 Lawn and garden only 10 Observation well
 Was a chemical/bacteriological sample submitted to Department? Yes.....No ; If yes, mo/day/yr sample was submitted
 Water Well Disinfected? Yes No

5 TYPE OF BLANK CASING USED:
 1 Steel 3 RMP (SR) 5 Wrought iron 8 Concrete tile CASING JOINTS: Glued Clamped
 2 PVC 4 ABS 6 Asbestos-Cement 9 Other (specify below) Welded
 7 Fiberglass Threaded
 Blank casing diameter: 5.1 in. to 5.6 ft., Dia in. to ft., Dia in. to ft.
 Casing height above land surface: 1.8 in., weight 2.843 lbs./ft. Wall thickness or gauge No. 20.0 PSI
 TYPE OF SCREEN OR PERFORATION MATERIAL:
 1 Steel 3 Stainless steel 5 Fiberglass 8 RMP (SR) 10 Asbestos-cement
 2 Brass 4 Galvanized steel 6 Concrete tile 9 ABS 11 Other (specify)
 12 None used (open hole)
 SCREEN OR PERFORATION OPENINGS ARE:
 1 Continuous slot 3 Mill slot 5 Gauzed wrapped 8 Saw cut 11 None (open hole)
 2 Louvered shutter 4 Key punched 6 Wire wrapped 9 Drilled holes
 7 Torch cut 10 Other (specify)
 SCREEN-PERFORATED INTERVALS: From 5.6 ft. to 7.6 ft., From ft. to ft.
 From ft. to ft., From ft. to ft.
 GRAVEL PACK INTERVALS: From 2.5 ft. to 7.6 ft., From ft. to ft.
 From ft. to ft., From ft. to ft.

6 GROUT MATERIAL: 1 Neat cement 2 Cement grout 3 Bentonite 4 Other
 Grout intervals: From 5 ft. to 1.8 ft., From ft. to ft., From ft. to ft.
 What is the nearest source of possible contamination:
 1 Septic tank 4 Lateral lines 7 Pit privy 10 Livestock pens 14 Abandoned water well
 2 Sewer lines 5 Cess pool 8 Sewage lagoon 11 Fuel storage 15 Oil well/Gas well
 3 Watertight sewer lines 6 Seepage pit 9 Feedyard 12 Fertilizer storage 16 Other (specify below) None known
 13 Insecticide storage

Direction from well? How many feet?

| FROM | TO | LITHOLOGIC LOG | FROM | TO | LITHOLOGIC LOG |
|------|------|-----------------|------|----|----------------|
| 0 | 4 | NS | | | |
| 4 | 17 | SANDY clay BR | | | |
| 17 | 32 | SANDY clay BR | | | |
| 32 | 33 | SANDY clay BR | | | |
| 33 | 34.5 | SAND BR VE-C | | | |
| 34.5 | 49.5 | SANDY clay BR | | | |
| 49.5 | 68.5 | SAND BR VE-C | | | |
| 68.5 | 73 | SANDY clay BR | | | |
| 73 | 76 | SANDY clay GRAY | | | |

7 CONTRACTOR'S OR LANDOWNER'S CERTIFICATION: This water well was (1) constructed (2) reconstructed, or (3) plugged under my jurisdiction and was completed on (mo/day/year) 2-17-89 and this record is true to the best of my knowledge and belief. Kansas
 Water Well Contractor's License No. 308 This Water Well Record was completed on (mo/day/yr) 2-17-89
 under the business name of Rieschick Drilling Co by (signature) Ray Rieschick

INSTRUCTIONS: Use typewriter or ball point pen. PLEASE PRESS FIRMLY and PRINT clearly. Please fill in blanks, underline or circle the correct answers. Send top three copies to Kansas Department of Health and Environment, Bureau of Water Protection, Topeka, Kansas 66620-7320, Telephone: 913-862-9360. Send one to WATER WELL OWNER and retain one for your records.

OFFICE USE ONLY
T
R
EW
SEC.