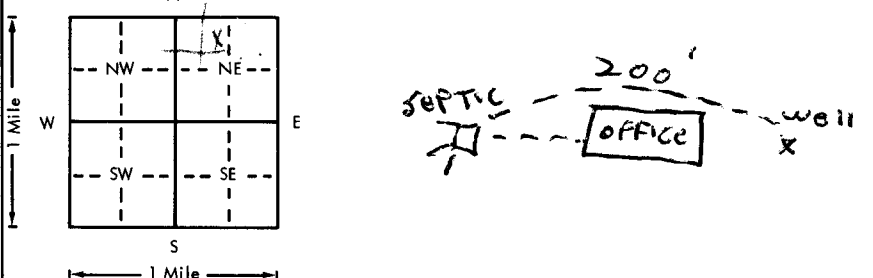


USE TYPEWRITER OR BALL
POINT PEN-PRESS FIRMLY,
PRINT CLEARLY.

WATER WELL RECORD
KSA 82a-1201-1215

A B A

Kansas Department of Health and
Environment-Division of Environment
(Water well Contractors)
Topeka, Kansas 66620

1. Location of well:		County BROWN	Fraction NE 1/4 NW 1/4 NE 1/4	Section number 17	Township number T 3 S	Range number R 16 W
2. Distance and direction from nearest town or city: 2.5 N 1/3 W of POWHATON		3. Owner of well: KANSAS STATE CORNBELT EXPERIMENT FIELD STATION		City, state, zip code: POWHERTTAN, KANSAS		
4. Locate with "X" in section below:		Sketch map:		6. Bore hole dia. 10 in. Completion date 7-25-77 Well depth 140 ft.		
				7. <input checked="" type="checkbox"/> Cable tool <input checked="" type="checkbox"/> Rotary <input type="checkbox"/> Driven <input type="checkbox"/> Dug <input type="checkbox"/> Hollow rod <input type="checkbox"/> Jetted <input type="checkbox"/> Bored <input type="checkbox"/> Reverse rotary		
5. Type and color of material		From	To	8. Use: <input checked="" type="checkbox"/> Domestic <input type="checkbox"/> Public supply <input type="checkbox"/> Industry <input type="checkbox"/> Irrigation <input type="checkbox"/> Air conditioning <input type="checkbox"/> Stock <input type="checkbox"/> Lawn <input type="checkbox"/> Oil field water <input type="checkbox"/> Other		
Top Soil		0	4	9. Casing: Material PVC Height Above or below Threaded <input type="checkbox"/> Welded <input type="checkbox"/> Surface 24 in. RMP PVC Weight 2.50 lbs./ft. Dia. 5 in. to 140 ft. depth Wall Thickness: inches or Dia. 5 in. to 140 ft. depth gage No. 258		
Brown Clay		4	18	10. Screen: Manufacturer's name MPI Type PVC Dia. 5 Slot/gauze 1020 Length 10 Set between 40 ft. and 80 ft. ft. and 80 ft. Gravel pack? <input checked="" type="checkbox"/> Size range of material 1020/1060		
Sandy Clay		18	50	11. Static water level: 30 ft. below land surface Date 7-25-77 mo./day/yr.		
Shale, Gray, LIME, Gray		50	140	12. Pumping level below land surfaces: ft. after 0 hrs. pumping 1/2 g.p.m. ft. after 0 hrs. pumping 1/2 g.p.m. Estimated maximum yield 1/2 g.p.m.		
				13. Water sample submitted: Yes <input checked="" type="checkbox"/> No <input type="checkbox"/> Date		
				14. Well head completion: CAP Pitless adapter 24 inches above grade		
				15. Well grouted? <input checked="" type="checkbox"/> With: <input type="checkbox"/> Neat cement <input type="checkbox"/> Bentonite <input type="checkbox"/> Concrete Depth: From 0 ft. to 10 ft.		
				16. Nearest source of possible contamination: ft. 200 Direction W Type SEPTIC Well disinfected upon completion? <input checked="" type="checkbox"/> Yes <input type="checkbox"/> No		
				17. Pump: Not installed Manufacturer's name Model number HP Volts Length of drop pipe ft. capacity g.p.m. Type: <input type="checkbox"/> Submersible <input type="checkbox"/> Turbine <input type="checkbox"/> Jet <input type="checkbox"/> Reciprocating <input type="checkbox"/> Centrifugal <input type="checkbox"/> Other		
18. Elevation: 1200		19. Remarks: OWNER TO INSTAL SCAB		20. Water well contractor's certification: This well was drilled under my jurisdiction and this report is true to the best of my knowledge and belief. STRAIDER DRILLING CO INC 182 Business name License No. Address HATTAN, KS Signed Don Anderson Date 7-26-77 Authorized representative		

BR = 1150

VI = 1150