


1 LOCATION OF WATER WELL: County: Brown Fraction: SW 1/4 SE 1/4 NW 1/4 Section Number: 28 Township Number: T 3 S Range Number: R 16 EW

Distance and direction from nearest town or city street address of well if located within city?
LOCATED IN THE CITY PARK

2 WATER WELL OWNER: KDHE - City of Pawhattan Board of Agriculture, Division of Water Resources
 RR#, St. Address, Box #: City Hall Application Number: MW#2
 City, State, ZIP Code: Pawhattan, KS 66527

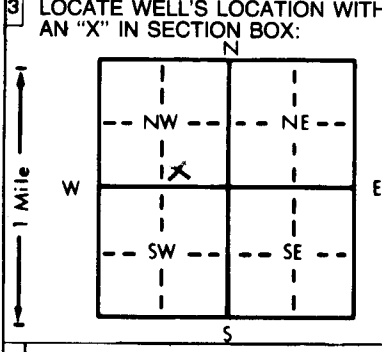

4 DEPTH OF COMPLETED WELL: 68.1 ft. ELEVATION: 1207.07 TOG
 Depth(s) Groundwater Encountered 1. 25 ft. 2. 49 ft. 3. _____ ft.
 WELL'S STATIC WATER LEVEL: 12.7 ft. below land surface measured on mo/day/yr 4/6/88
 Pump test data: Well water was _____ ft. after _____ hours pumping _____ gpm
 Est. Yield _____ gpm: Well water was _____ ft. after _____ hours pumping _____ gpm
 Bore Hole Diameter: 7.718 in. to 68.1 ft., and _____ in. to _____ ft.
 WELL WATER TO BE USED AS:
 5 Public water supply 8 Air conditioning 11 Injection well
 1 Domestic 3 Feedlot 6 Oil field water supply 9 Dewatering 12 Other (Specify below)
 2 Irrigation 4 Industrial 7 Lawn and garden only 10 Monitoring well MW#2
 Was a chemical/bacteriological sample submitted to Department? Yes X No _____; If yes, mo/day/yr sample was submitted 5/9/88 Water Well Disinfected? Yes No

5 TYPE OF BLANK CASING USED:
 1 Steel 3 RMP (SR) 5 Wrought iron 8 Concrete tile CASING JOINTS: Glued _____ Clamped _____
2 PVC 4 ABS 6 Asbestos-Cement 9 Other (specify below) Welded _____
 7 Fiberglass _____ Threaded _____
 Blank casing diameter 2 in. to 58.1 ft., Dia _____ in. to _____ ft., Dia _____ in. to _____ ft.
 Casing height above land surface _____ in., weight _____ lbs./ft. Wall thickness or gauge No. Sch#40
 TYPE OF SCREEN OR PERFORATION MATERIAL:
 1 Steel 3 Stainless steel 5 Fiberglass 8 RMP (SR) 10 Asbestos-cement
 2 Brass 4 Galvanized steel 6 Concrete tile 9 ABS 11 Other (specify) _____
 12 None used (open hole)
 SCREEN OR PERFORATION OPENINGS ARE:
 1 Continuous slot 3 Mill slot 5 Gauzed wrapped 8 Saw cut 11 None (open hole)
 2 Louvered shutter 4 Key punched 6 Wire wrapped 9 Drilled holes
 7 Torch cut 10 Other (specify) _____
 SCREEN-PERFORATED INTERVALS: From 58.1 ft. to 68.1 ft., From _____ ft. to _____ ft.
 From _____ ft. to _____ ft., From _____ ft. to _____ ft.
 GRAVEL PACK INTERVALS: From 56.1 ft. to 68.1 ft., From _____ ft. to _____ ft.
 From _____ ft. to _____ ft., From _____ ft. to _____ ft.

6 GROUT MATERIAL: 1 Neat cement 2 Cement grout 3 Bentonite 4 Other _____
 Grout Intervals: From 0 ft. to 20 ft., From 53 ft. to 56 ft., From _____ ft. to _____ ft.
 What is the nearest source of possible contamination:
 1 Septic tank 4 Lateral lines 7 Pit privy 10 Livestock pens 14 Abandoned water well
 2 Sewer lines 5 Cess pool 8 Sewage lagoon 11 Fuel storage 15 Oil well/Gas well
 3 Watertight sewer lines 6 Seepage pit 9 Feedyard 12 Fertilizer storage 16 Other (specify below) _____
13 Insecticide storage
 Direction from well? North How many feet? 200

FROM	TO	LITHOLOGIC LOG	FROM	TO	PLUGGING INTERVALS
<u>0</u>	<u>3</u>	<u>Top soil, black silty clay loam</u>			
<u>3</u>	<u>43</u>	<u>Yellow grey to reddish brown clay and silt; moisture at 25'</u>			
<u>43</u>	<u>49</u>	<u>Grey clay with soft white lime nodules up to 6mm</u>			
<u>49</u>	<u>65</u>	<u>Grey clay and fine sub-angular sand</u>			
<u>65</u>	<u>67</u>	<u>Grey clay and gravel mix, water zone</u>			
<u>67</u>	<u>-</u>	<u>blue grey shale</u>			

7 CONTRACTOR'S OR LANDOWNER'S CERTIFICATION: This water well was (1) constructed, (2) reconstructed, or (3) plugged under my jurisdiction and was completed on (mo/day/year) 3/30/88 and this record is true to the best of my knowledge and belief. Kansas Water Well Contractor's License No. _____ This Water Well Record was completed on (mo/day/yr) 6/13/88 under the business name of KDHE by (signature) [Signature]