


1 LOCATION OF WATER WELL: Fraction NW 1/4 NE 1/4 NW 1/4 Section Number 29 Township Number T 3 S Range Number R 16 EW
 County: BROWN
 Distance and direction from nearest town or city street address of well if located within city?

X 1/2 MILE NORTH AND 1/2 MILE WEST POWHATAN, KANSAS

2 WATER WELL OWNER: WELDON W. CLOPTON
 RR#, St. Address, Box # X RR 1 BOX 136 Board of Agriculture, Division of Water Resources
 City, State, ZIP Code POWHATAN, KANSAS 66527-9736 Application Number:

3 LOCATE WELL'S LOCATION WITH AN "X" IN SECTION BOX: 4 DEPTH OF COMPLETED WELL: 1180 ft. ELEVATION: X 1180

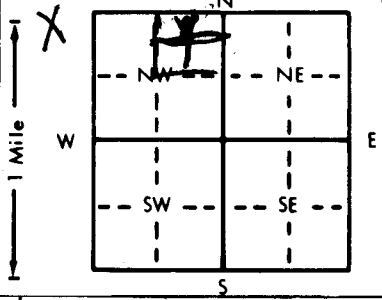

Depth(s) Groundwater Encountered 1. 38 ft. 2. ft. 3. ft.
 WELL'S STATIC WATER LEVEL 32 ft. below land surface measured on mo/day/yr 6-14-89
 Pump test data: Well water was 42 ft. after 1 hours pumping 4 gpm
 Est. Yield 2 gpm; Well water was ft. after hours pumping gpm
 Bore Hole Diameter 54 in. to 20 ft., and 42 in. to 52 ft.
 WELL WATER TO BE USED AS:
 1 Domestic 3 Feedlot 6 Oil field water supply 9 Dewatering 12 Other (Specify below)
 2 Irrigation 4 Industrial 7 Lawn and garden only 10 Monitoring well
 Was a chemical/bacteriological sample submitted to Department? Yes No; If yes, mo/day/yr sample was submitted
 Water Well Disinfected? Yes No

5 TYPE OF BLANK CASING USED:
 1 Steel 3 RMP (SR) 5 Wrought iron 8 Concrete tile CASING JOINTS: Glued Clamped
 2 PVC 4 ABS 6 Asbestos-Cement 9 Other (specify below) Welded
 Blank casing diameter 42 in. to 52 ft. Dia. in. to ft. Dia. in. to ft.
 Casing height above land surface 26 in., weight 320 lbs./ft. Wall thickness or gauge No. 3 in.

TYPE OF SCREEN OR PERFORATION MATERIAL:
 1 Steel 3 Stainless steel 5 Fiberglass 8 RMP (SR) 11 Other (specify)
 2 Brass 4 Galvanized steel 6 Concrete tile 9 ABS 12 None used (open hole)

SCREEN OR PERFORATION OPENINGS ARE:
 1 Continuous slot 3 Mill slot 5 Gauzed wrapped 8 Saw cut 11 None (open hole)
 2 Louvered shutter 4 Key punched 6 Wire wrapped 9 Drilled holes
 7 Torch cut 10 Other (specify)

SCREEN-PERFORATED INTERVALS: From ft. to ft., From ft. to ft., From ft. to ft.
 GRAVEL PACK INTERVALS: From ft. to ft., From ft. to ft., From ft. to ft.

6 GROUT MATERIAL: 1 Neat cement 2 Cement grout 3 Bentonite 4 Other
 Grout Intervals: From 0 ft. to 20 ft., From ft. to ft., From ft. to ft.

What is the nearest source of possible contamination:
 1 Septic tank 4 Lateral lines 7 Pit privy 10 Livestock pens 14 Abandoned water well
 2 Sewer lines 5 Cess pool 8 Sewage lagoon 11 Fuel storage 15 Oil well/Gas well
 3 Watertight sewer lines 6 Seepage pit 9 Feedyard 12 Fertilizer storage 16 Other (specify below)
 13 Insecticide storage
 Direction from well? How many feet? 200

FROM	TO	LITHOLOGIC LOG	FROM	TO	PLUGGING INTERVALS
0	2	BLACK TOP SOIL			
2	26	VERY HARD YELLOW CLAY			
26	38	SAME WITH CHALK ROCK			
38	42	EGG SIZE YELLOW GRAVEL - PRODUCES WATER			
42	52	BLUE / GRAY SHALE GETS VERY HARD NEAR 52'			
52		BOTTOM HARD BLUE SHALE			

7 CONTRACTOR'S OR LANDOWNER'S CERTIFICATION: This water well was (1) constructed (2) reconstructed, or (3) plugged under my jurisdiction and was completed on (mo/day/year) 6-13-89 and this record is true to the best of my knowledge and belief. Kansas Water Well Contractor's License No. 320 This Water Well Record was completed on (mo/day/yr) 7-2-89 under the business name of POPPEWELL WELL BORING by (signature) Jerry Poppewell