


USE TYPEWRITER OR BALL POINT PEN-PRESS FIRMLY, PRINT CLEARLY.

WATER WELL RECORD
KSA 82a-1201-1215

Kansas Department of Health and Environment-Division of Environment (Water well Contractors) Topeka, Kansas 66620

1. Location of well: County **Brown** Fraction **SE 1/4 SE 1/4 SE 1/4** Section number **30** Township number **T 3** Range number **16** **(S) R 16 (EW)**

2. Distance and direction from nearest town or city: **1 1/2 mi. south, 1 1/2 mi. west of Powhattan.**
Street address of well location if in city:
3. Owner of well: **Edith Johnson**
R.R. or street: **R. R. # 1**
City, state, zip code: **Powhattan, Kansas 66527**

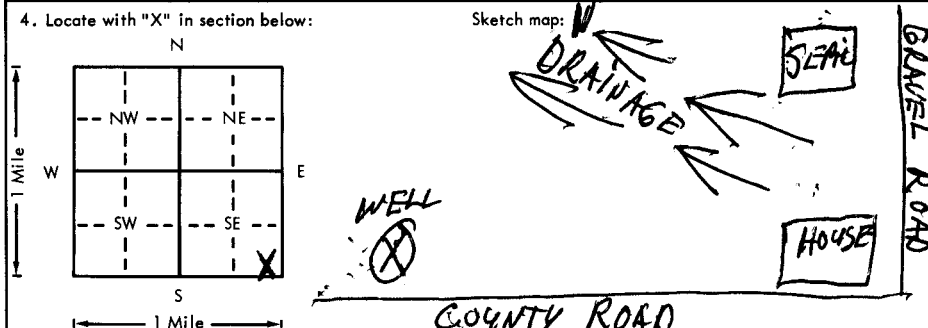

6. Bore hole dia. **35** in. Completion date **1-4-82**
Well depth **23** ft. Bore hole **44** in. **to 11 feet**

7. Cable tool Rotary Driven Dug
 Hollow rod Jetted Red Reverse rotary

8. Use: Domestic Public supply Industry
 Irrigation Air conditioning Stock
 Lawn Oil field water Other

9. Casing: Material **Concrete** Above or below
Threaded Welded Surface **30** in.
RMP PVC Weight **200** lbs./ft.
Dia. **30** in. to **23** ft. depth Wall Thickness: inches or
Dia. in. to ft. depth gage No. **2 in.**

5. Type and color of material

	From	To
Black top soil	0	2
Yellow-brown clay - hard	2	14
Brown sand and gravel mixed with clay - produces some water	14	18
Blue- gray shale - very hard	18	22
Soft limestone bedrock	22	23
(Use a second sheet if needed)		

10. Screen: Manufacturer's name _____
Type _____ Dia. _____
Slot/gauze _____ Length _____
Set between _____ ft. and _____ ft.
_____ ft. and _____ ft.
Gravel pack? Size range of material _____

11. Static water level: **1-4-82** mo./day/yr.
14 ft. below land surface Date **1-4-82**

12. Pumping level below land surfaces:
15 ft. after **1** hrs. pumping **4** g.p.m.
18 ft. after **3** hrs. pumping **4** g.p.m.
Estimated maximum yield **2 1/2** g.p.m.

13. Water sample submitted: _____ mo./day/yr.
Yes No Date _____

14. Well head completion: _____
Pitless adapter _____ Inches above grade

15. Well grouted? **Yes**
With: Neat cement Bentonite Concrete
Depth: From **0** ft. to **11** ft.

16. Nearest source of possible contamination:
ft. **1000** Direction **NE** Type **Septic**
Well disinfected upon completion? Yes No

17. Pump: **Not installed**
Manufacturer's name _____
Model number _____ HP _____ Volts _____
Length of drop pipe _____ ft. capacity _____ g.p.m.
Type:
 Submersible Turbine
 Jet Reciprocating
 Centrifugal Other

18. Elevation: **1149** *km*
Topography: Hill Slope Upland Valley

19. Remarks: **X Edith Johnson**

20. Water well contractor's certification:
This well was drilled under my jurisdiction and this report is true to the best of my knowledge and belief.
Popplewell Bwellboring 320
Business name _____ License No. _____
Address **Abity, Mo. 64422**
Signed **Jerry Popplewell** Date **Jan 30, 1982**
Authorized Representative

1-3-16-30
 Sec 30
 1/4 1/4
 SE SE SE SE
 SE SE SE SE