

92

Hiawatha

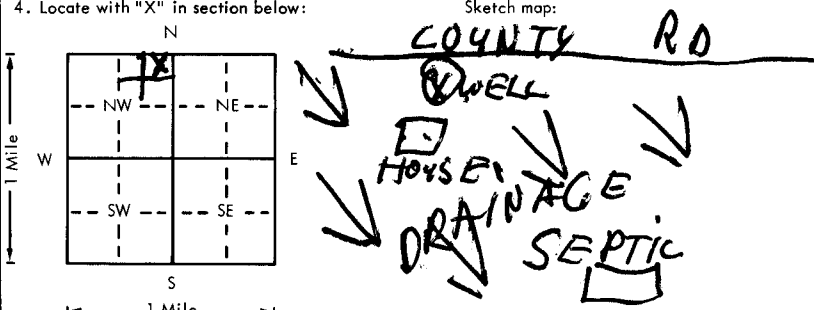
VJD

USE TYPEWRITER OR BALL  
POINT PEN-PRESS FIRMLY,  
PRINT CLEARLY.

WATER WELL RECORD  
KSA 82a-1201-1215

BAA

Kansas Department of Health and  
Environment-Division of Environment  
(Water well Contractors)  
Topeka, Kansas 66620

1. Location of well:	County <b>Brown</b>	Fraction <b>NE 1/4 NE 1/4 NW 1/4</b>	Section number <b>36</b>	Township number <b>T 3 S R 16</b>	Range number <b>16</b>
2. Distance and direction from nearest town or city: <b>1/2 mile south and 2 1/2 miles east of Powhattan, Kansas</b> Street address of well location if in city:			3. Owner of well: <b>Mildred I. PEDERSON</b> R.R. or street: <b>R.R. 5 Hiawatha, Kansas 66434</b> City, state, zip code: <b>Hiawatha, Kansas 66434</b>		
4. Locate with "X" in section below: 			6. Bore hole dia. <b>36</b> in. Completion date <b>7/7/82</b> Well depth <b>60</b> ft. Bore hole <b>1 1/4</b> to <b>11</b> ft.		
5. Type and color of material			7. Cable tool <input type="checkbox"/> Rotary <input type="checkbox"/> Driven <input type="checkbox"/> Dug <input type="checkbox"/> <input type="checkbox"/> Hollow rod <input type="checkbox"/> Jetted <input checked="" type="checkbox"/> Bored <input type="checkbox"/> Reverse rotary		
Black topsoil			8. Use: <input checked="" type="checkbox"/> Domestic <input type="checkbox"/> Public supply <input type="checkbox"/> Industry <input type="checkbox"/> <input type="checkbox"/> Irrigation <input type="checkbox"/> Air conditioning <input type="checkbox"/> Stock <input type="checkbox"/> Lawn <input type="checkbox"/> Oil field water <input type="checkbox"/> Other		
Gray clay			9. Casing: Material <b>Concrete</b> Above or below Threaded <input type="checkbox"/> Welded <input type="checkbox"/> Surface <b>22</b> in. RMP <input type="checkbox"/> PVC <input type="checkbox"/> Weight <b>200</b> lbs./ft. Dia. <b>30</b> in. to <b>52</b> ft. depth Wall thickness: inches or Dia. <b>30</b> in. to <b>52</b> ft. depth gage No. <b>2</b> in.		
Hard brown clay			10. Screen: Manufacturer's name _____ Type _____ Dia. _____ Slot/gauze _____ Length _____ Set between _____ ft. and _____ ft. _____ ft. and _____ ft. Gravel pack? _____ Size range of material _____		
Same with small pebbles			11. Static water level: _____ mo./day/yr. <b>43</b> ft. below land surface Date <b>7/5/82</b>		
Dry yellow - brown coarse sand and gravel			12. Pumping level below land surfaces: <b>18</b> ft. after <b>2</b> hrs. pumping <b>20</b> g.p.m. <b>52</b> ft. after <b>3</b> hrs. pumping <b>20</b> g.p.m. Estimated maximum yield <b>8</b> g.p.m.		
Brown - yellow sand and gravel with gravel egg size near 58 feet			13. Water sample submitted: _____ mo./day/yr. <input type="checkbox"/> Yes <input checked="" type="checkbox"/> No Date _____		
Very productive			14. Well head completion: _____ <input type="checkbox"/> Pitless adapter _____ inches above grade		
Hard blue clay			15. Well grouted? <input checked="" type="checkbox"/> With: <input checked="" type="checkbox"/> Neat cement <input type="checkbox"/> Bentonite <input type="checkbox"/> Concrete Depth: From <b>0</b> ft. to <b>11</b> ft.		
(Use a second sheet if needed)			16. Nearest source of possible contamination: ft. <b>100</b> Direction <b>SE</b> Type <b>septic</b> Well disinfected upon completion? <input checked="" type="checkbox"/> Yes <input type="checkbox"/> No		
			17. Pump: <input checked="" type="checkbox"/> Not installed Manufacturer's name _____ Model number _____ HP _____ Volts _____ Length of drop pipe _____ ft. capacity _____ g.p.m. Type: <input type="checkbox"/> Submersible <input type="checkbox"/> Turbine <input type="checkbox"/> Jet <input type="checkbox"/> Reciprocating <input type="checkbox"/> Centrifugal <input type="checkbox"/> Other		
18. Elevation: <b>1175</b> Topography: <input type="checkbox"/> Hill <input checked="" type="checkbox"/> Slope <input type="checkbox"/> Upland <input type="checkbox"/> Valley	19. Remarks:		20. Water well contractor's certification: This well was drilled under my jurisdiction and this report is true to the best of my knowledge and belief. <b>Popelevell Well Boring</b> <b>320</b> Business name <b>Amity, Mo. 64422</b> License No. _____ Address _____ Signed <b>Jerry Popelevell</b> Date <b>8/3/82</b> Authorized representative		

Forward the white, blue and pink copies to the Department of Health and Environment

Form WWC-5