


1 LOCATION OF WATER WELL: County: Brown, Fraction: NW 1/4 NE 1/4 SW 1/4, Section Number: 28, Township Number: T 3 S, Range Number: R 16 E/W

Distance and direction from nearest town or city street address of well if located within city? Center Street north of First Street, Powhattan

2 WATER WELL OWNER: Ag Partners Coop Inc, RR#: 200 E Main St, City, State, ZIP Code: Powhattan, KS 66527, Board of Agriculture, Division of Water Resources, Application Number:

3 LOCATE WELL'S LOCATION WITH AN "X" IN SECTION BOX:

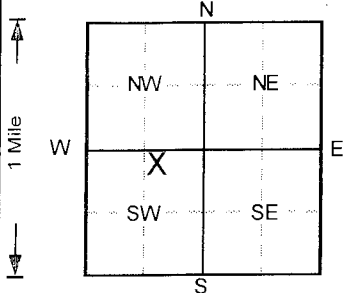

4 DEPTH OF COMPLETED WELL: 60 ft. ELEVATION: 1206. WELL'S STATIC WATER LEVEL: ... ft. below land surface measured on mo/day/yr. Pump test data: Well water was NA ft after ... hours pumping ... gpm. Est. Yield NA gpm. Bore Hole Diameter: 8 in. to 60 ft. WELL WATER TO BE USED AS: 10 Monitoring well.

5 TYPE OF BLANK CASING USED: 2 PVC, Blank casing diameter 2 in. to 40 ft., Dia. 40 in. to ... ft., Dia. in. to ... ft. TYPE OF SCREEN OR PERFORATION MATERIAL: 7 PVC, 10 Asbestos-cement. SCREEN OR PERFORATION OPENINGS ARE: 3 Mill slot. SCREEN-PERFORATED INTERVALS: From 40 ft. to 60 ft. GRAVEL PACK INTERVALS: From 38 ft. to 60 ft.

6 GROUT MATERIAL: 1 Neat cement, 3 Bentonite. Grout intervals: From 0 ft. to 2 ft., From 2 ft. to 38 ft. What is the nearest source of possible contamination: 10 Livestock pens, 14 Abandoned water well.

LITHOLOGIC LOG table with columns: FROM, TO, LITHOLOGIC LOG, FROM, TO, PLUGGING INTERVALS. Entries: 0-3 Topsoil - Silt, v. clayey, v. sl. sandy, Dark Bro; 3-47 Clay, silty, Med. Brown; 47-53 Sand, v. clayey, Tan; 53-57 Clay, silty, Med. Brown; 57-60 Shale, wthrd. grading into firm.

7 CONTRACTOR'S OR LANDOWNER'S CERTIFICATION: This water well was (1) constructed, (2) reconstructed, or (3) plugged under my jurisdiction and was completed on (mo/day/year) 11/19/2012. Kansas Water Well Contractor's License No. 527. This Water Well Record was completed on (mo/day/yr) 12/14/2012 under the business name of GeoCore, Inc. by (signature) Rob Bell

INSTRUCTIONS: Use typewriter or ball point pen. PLEASE PRESS FIRMLY and PRINT clearly. Please fill in blanks, underline or circle the correct answers. Send top three copies to Kansas Department of Health and Environment, Bureau of Water, Topeka, Kansas 66620-0001. Telephone: 913-296-5545. Send one to WATER WELL OWNER and retain one for your records.

OFFICE USE ONLY

T

R

EW

SEC.

1/4

1/4

1/4